

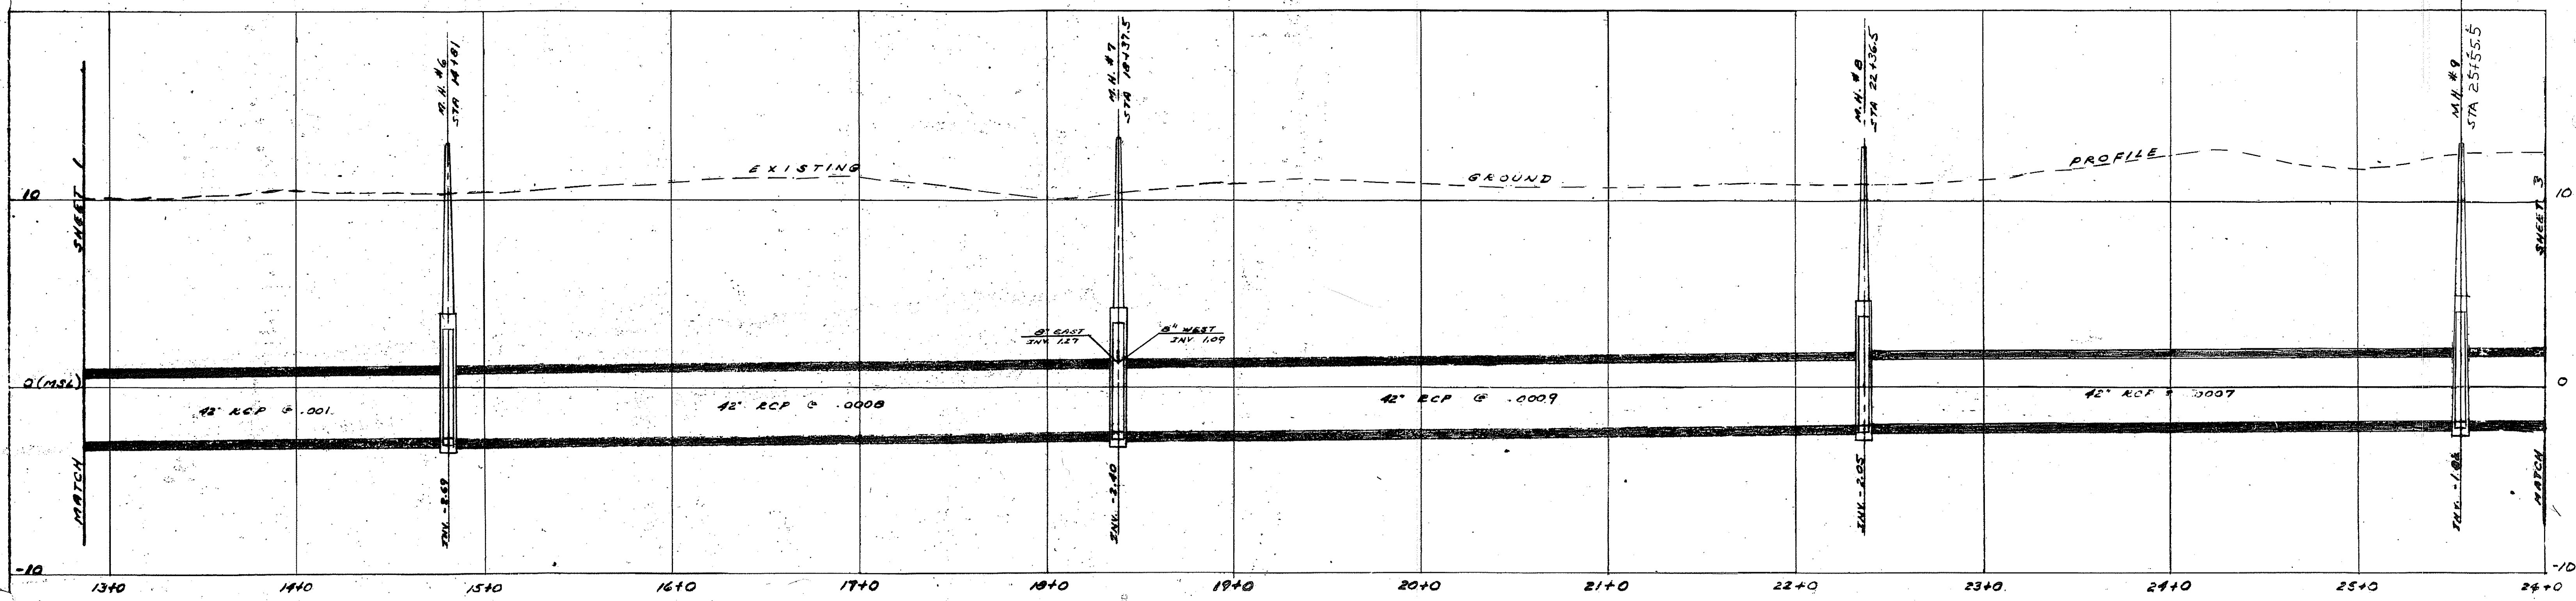
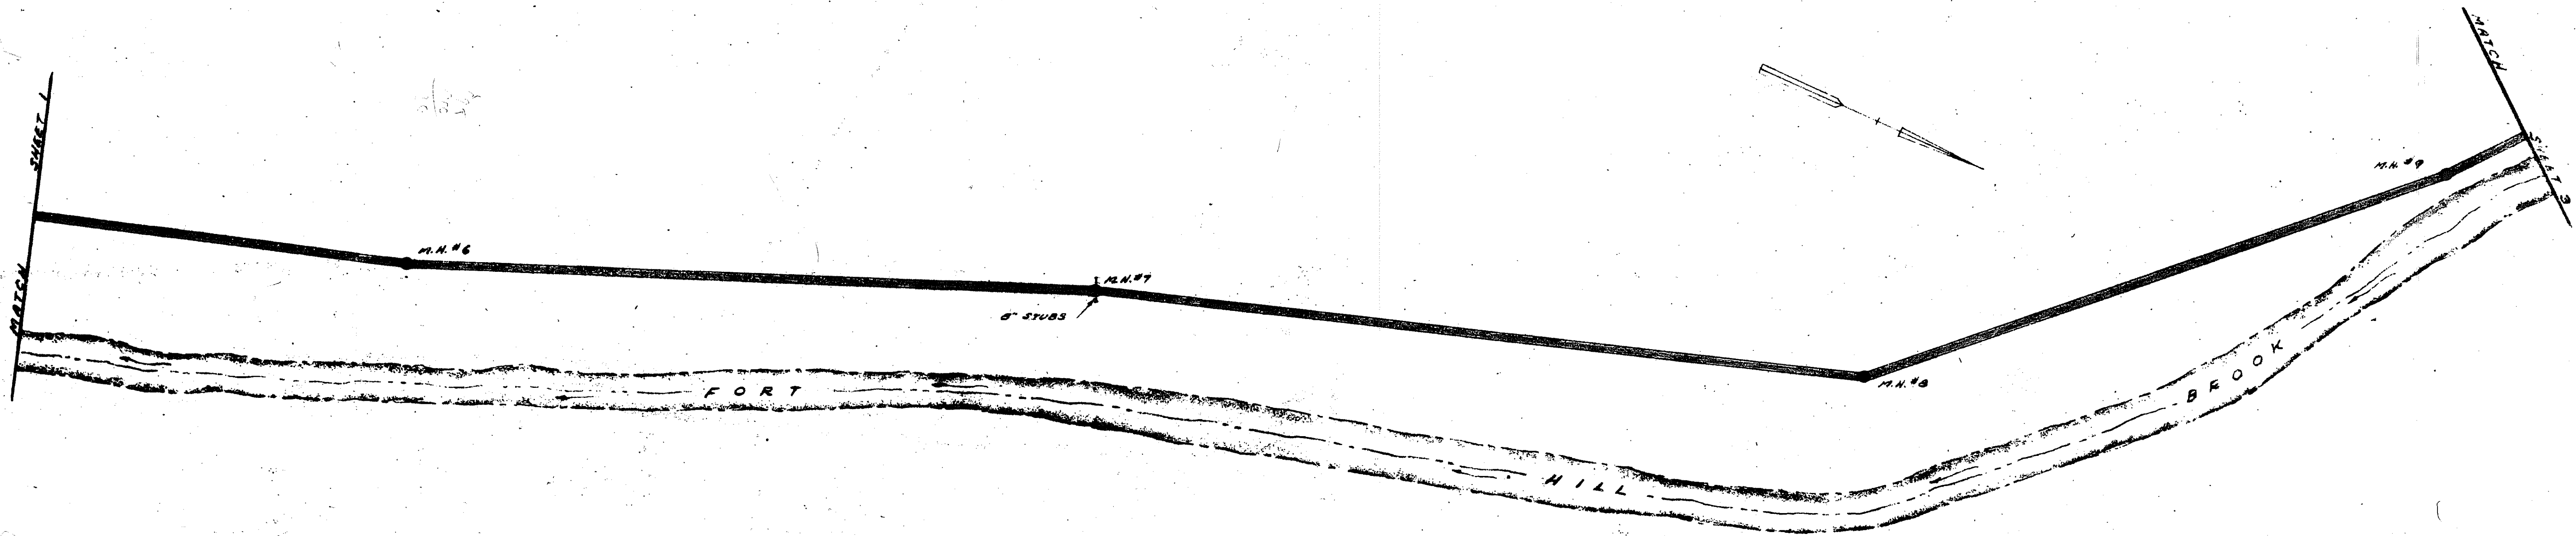
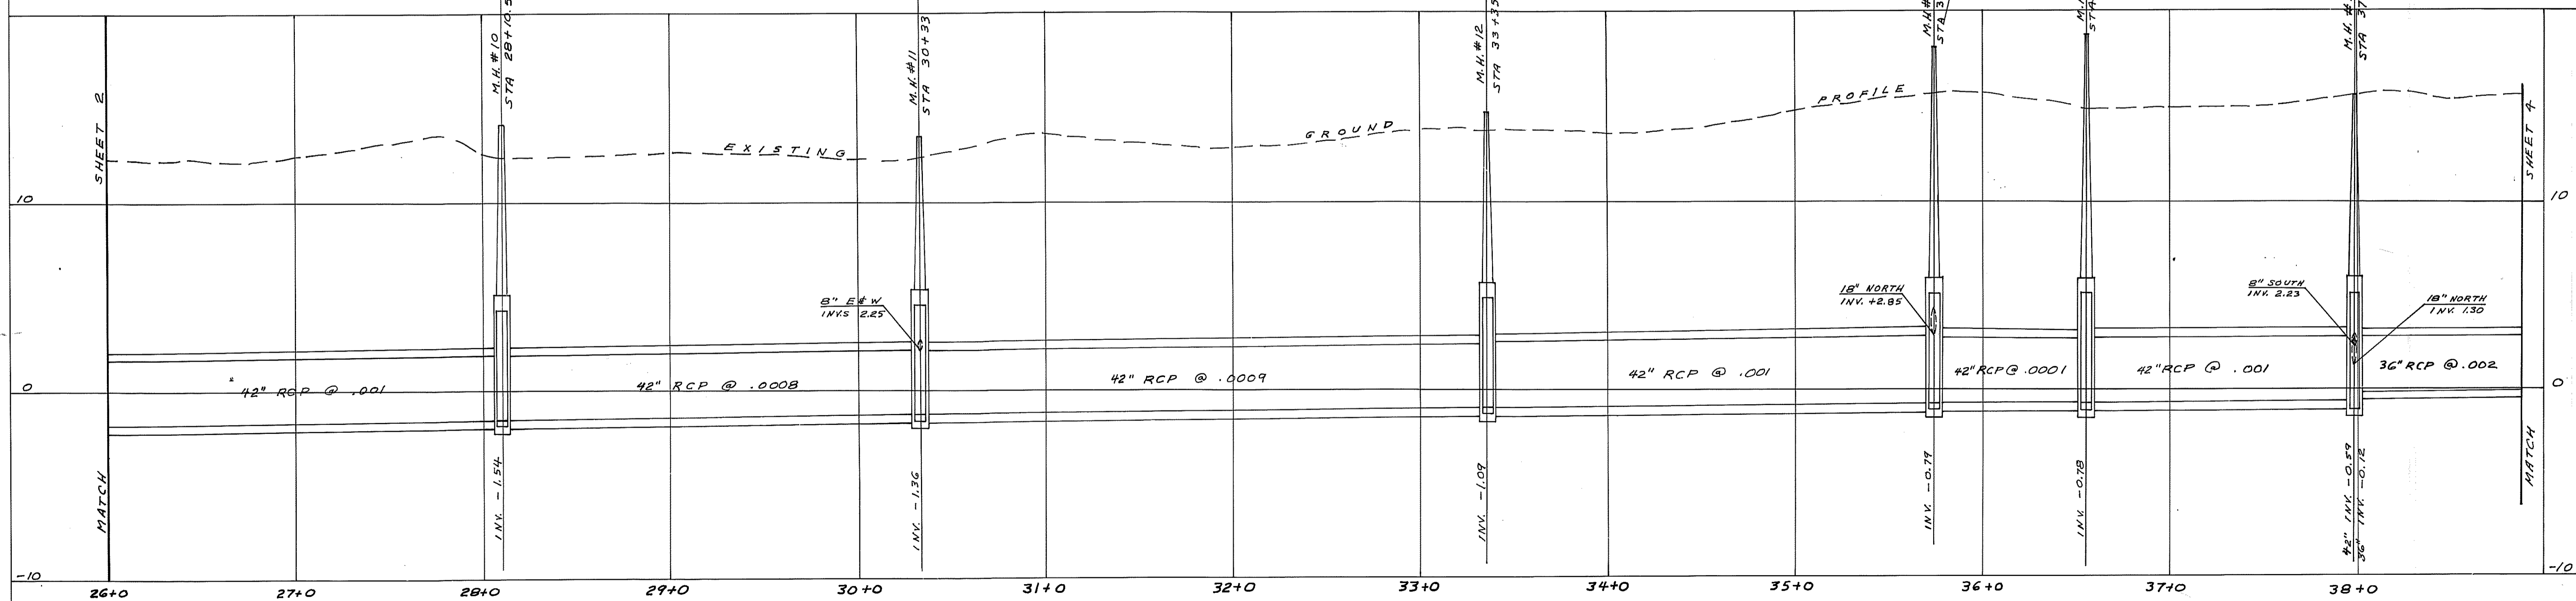


TOWN OF GROTON
 SANITARY SEWER RECORD PLAN PG2
 LONG HILL TRUNK SEWER-FORT HILL BROOK
 SCALE: HORIZ. 1"=40'
 VERT. 1"=4'
 PREPARED BY _____ JUNE 1970

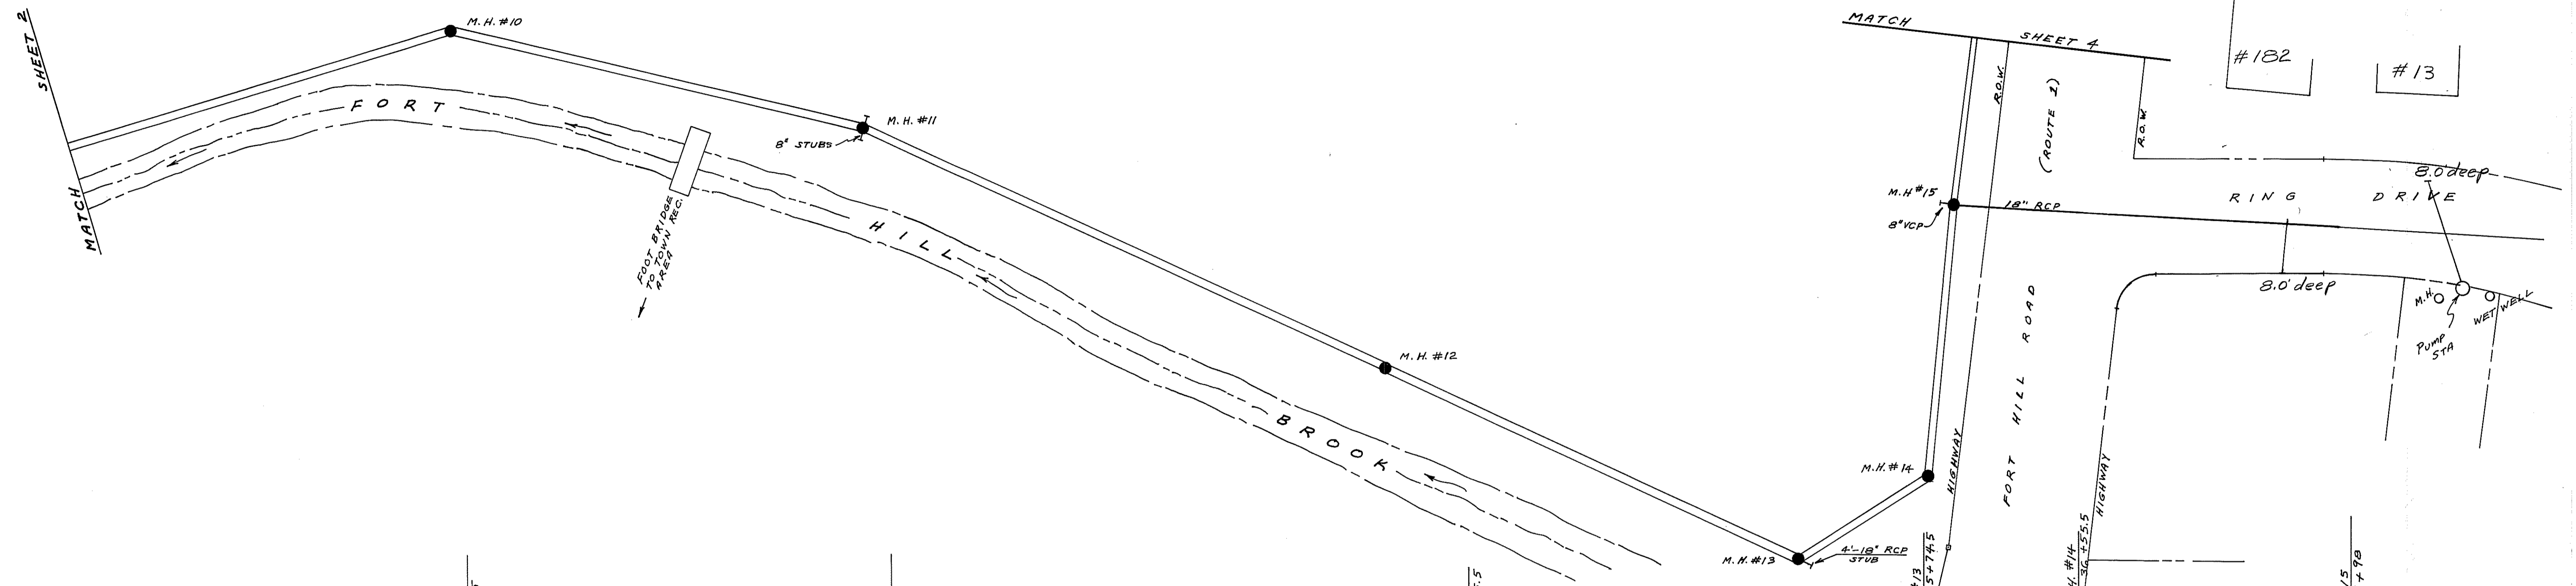


POCKET 18
 FOLDER 4
 PLAN 16 B

TOWN OF GROTON
 SANITARY SEWER RECORD PLAN P63
 LONG HILL TRUNK SEWER - FORT HILL BROOK
 HORIZ. 1"=40'
 VERT. 1"=4'
 PREPARED BY
 THE DEPARTMENT OF PUBLIC WORKS

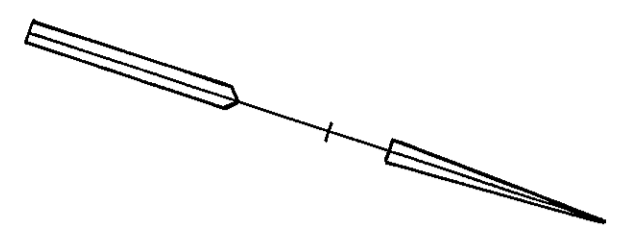


TOWN OF GROTON
 SANITARY SEWER RECORD PLAN **P64**
 LONG HILL TRUNK SEWER - FORT HILL BROOK
 HORIZ. 1"=40'
 SCALE: VERT. 1"=4'
 JUNE 1970
 PREPARED BY
 THE DEPARTMENT OF PUBLIC WORKS
 AS BUILT LONG HILL TRUNK SHEET 3 OF 15

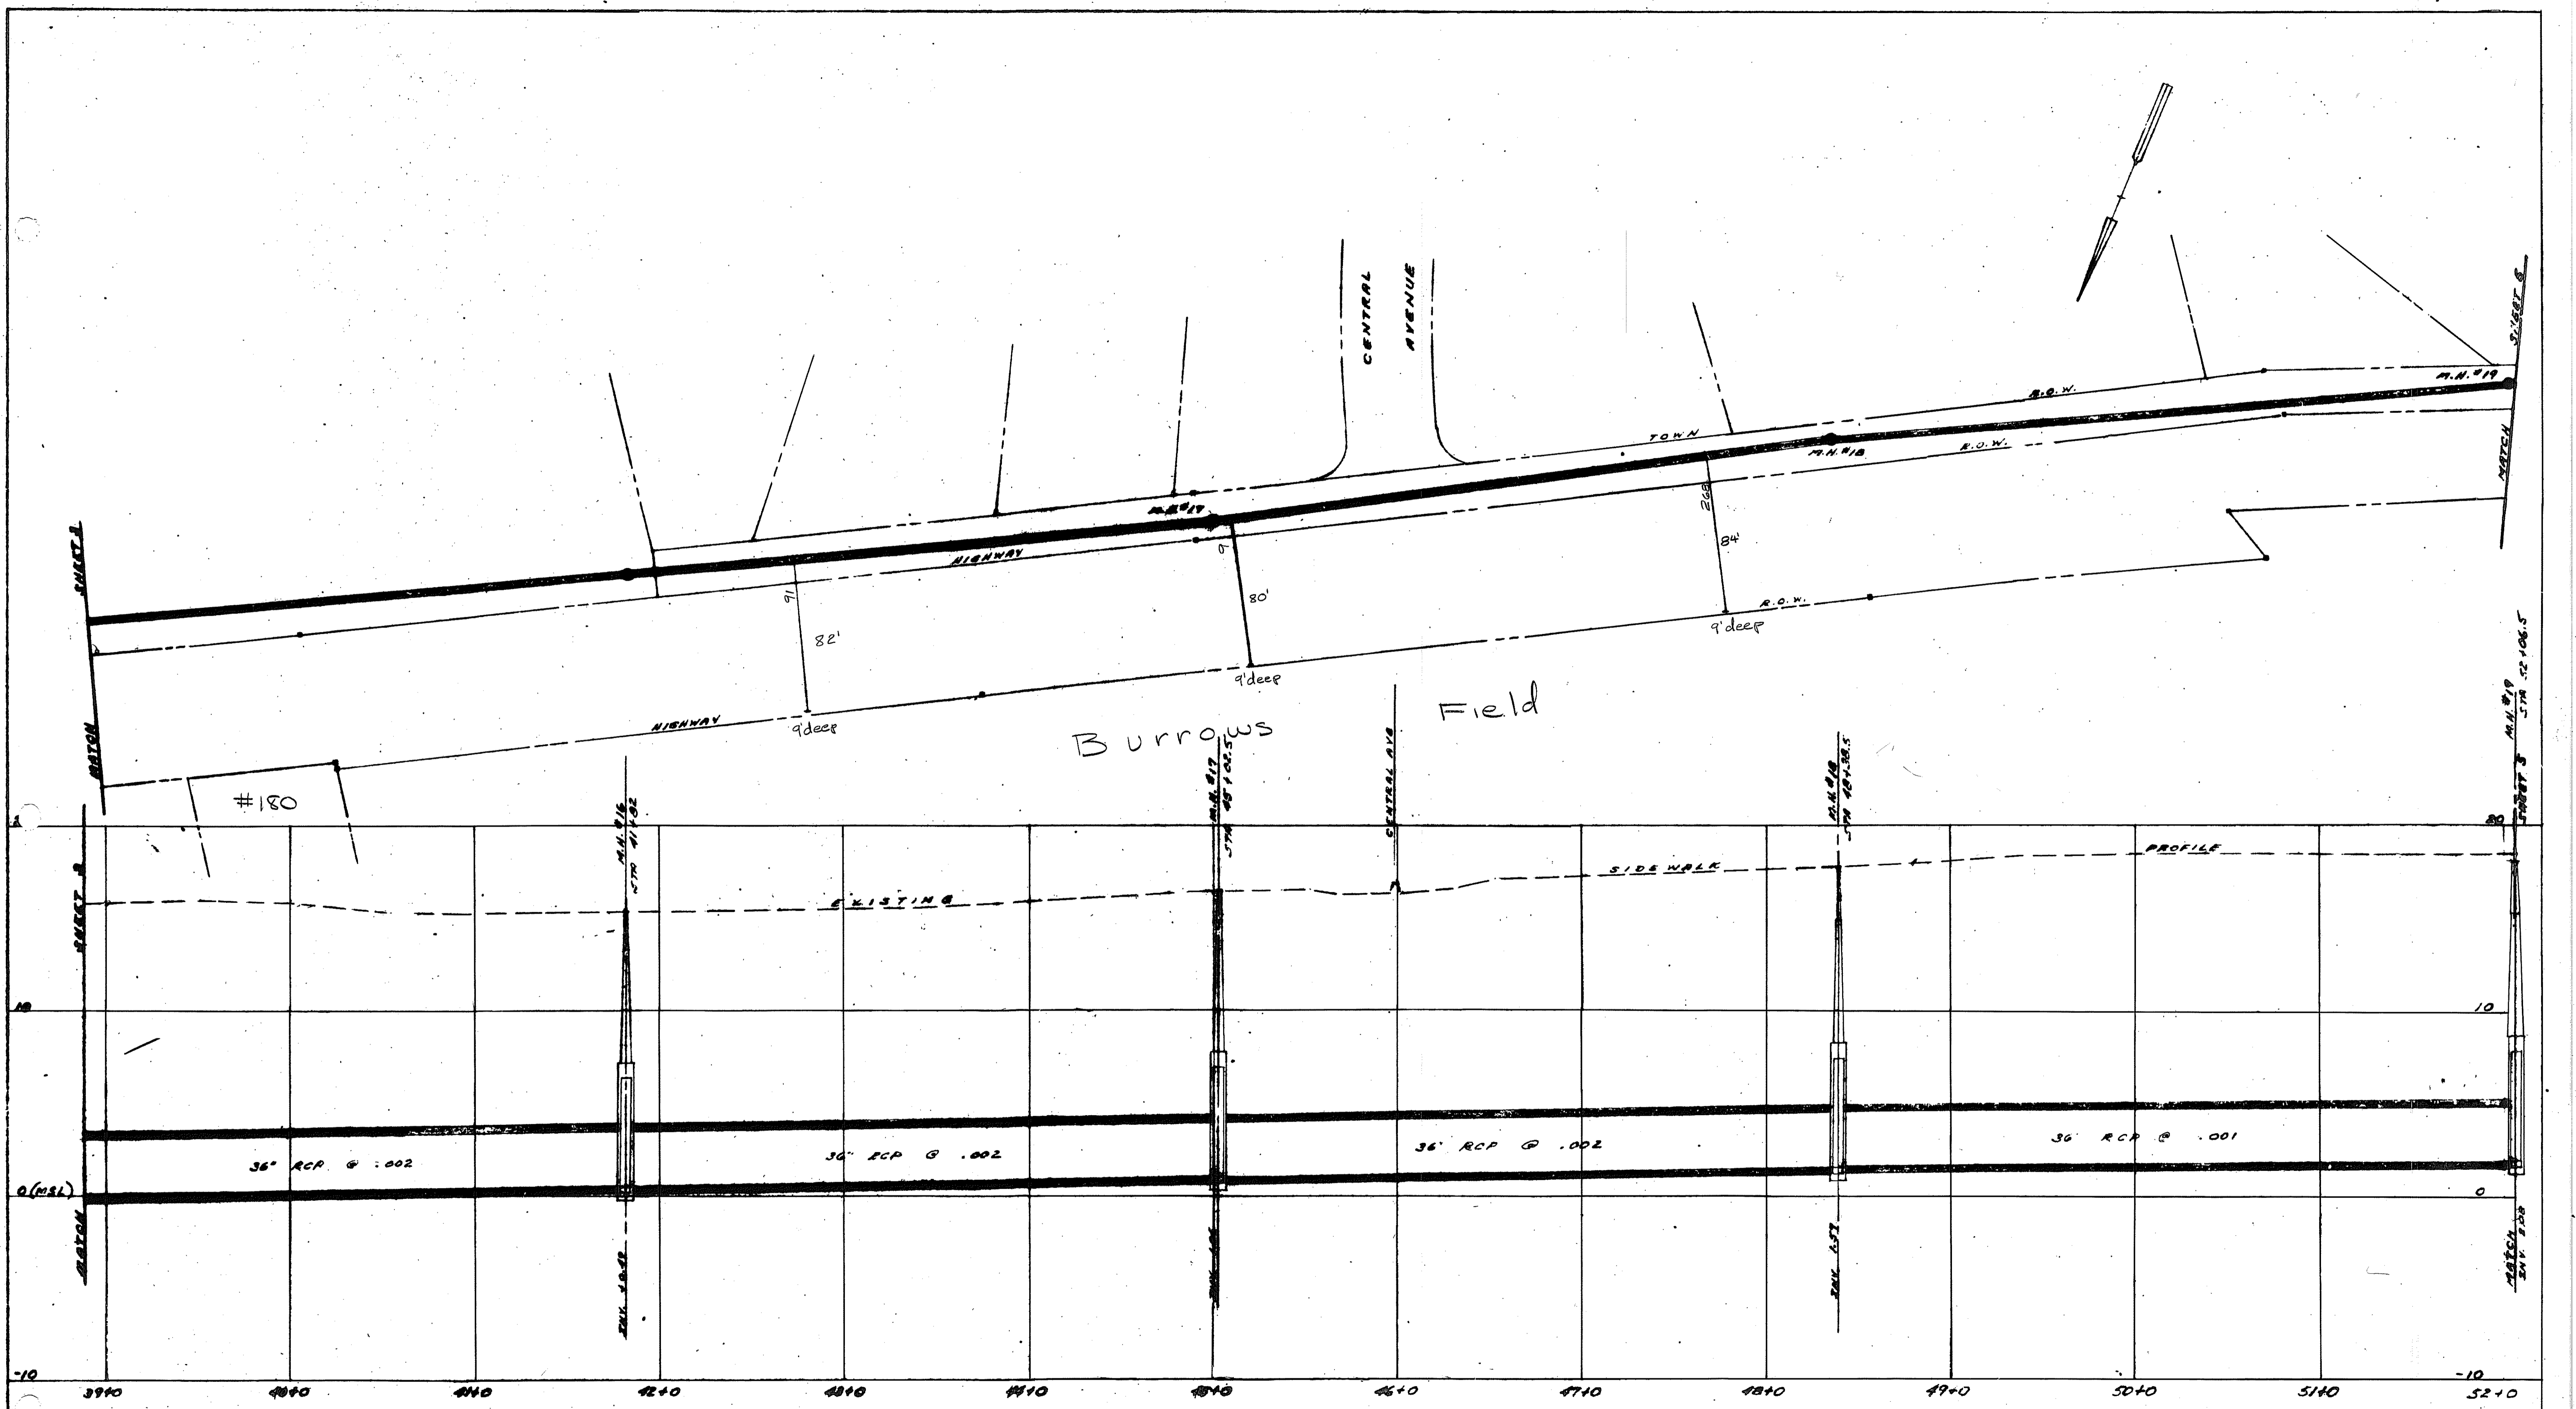

TOWN OF GROTON
 SANITARY SEWER RECORD PLAN P65
 LONG HILL TRUNK SEWER - FORT HILL ROAD
 HORIZ. 1"=40'
 SCALE: VERT. 1"=4'


POCKET	12
FOLDER	4
PLAN	16 D

PREPARED BY
 THE DEPARTMENT OF PUBLIC WORKS
 AS BUILT LONG HILL TRUNK SHEET 4 OF 15

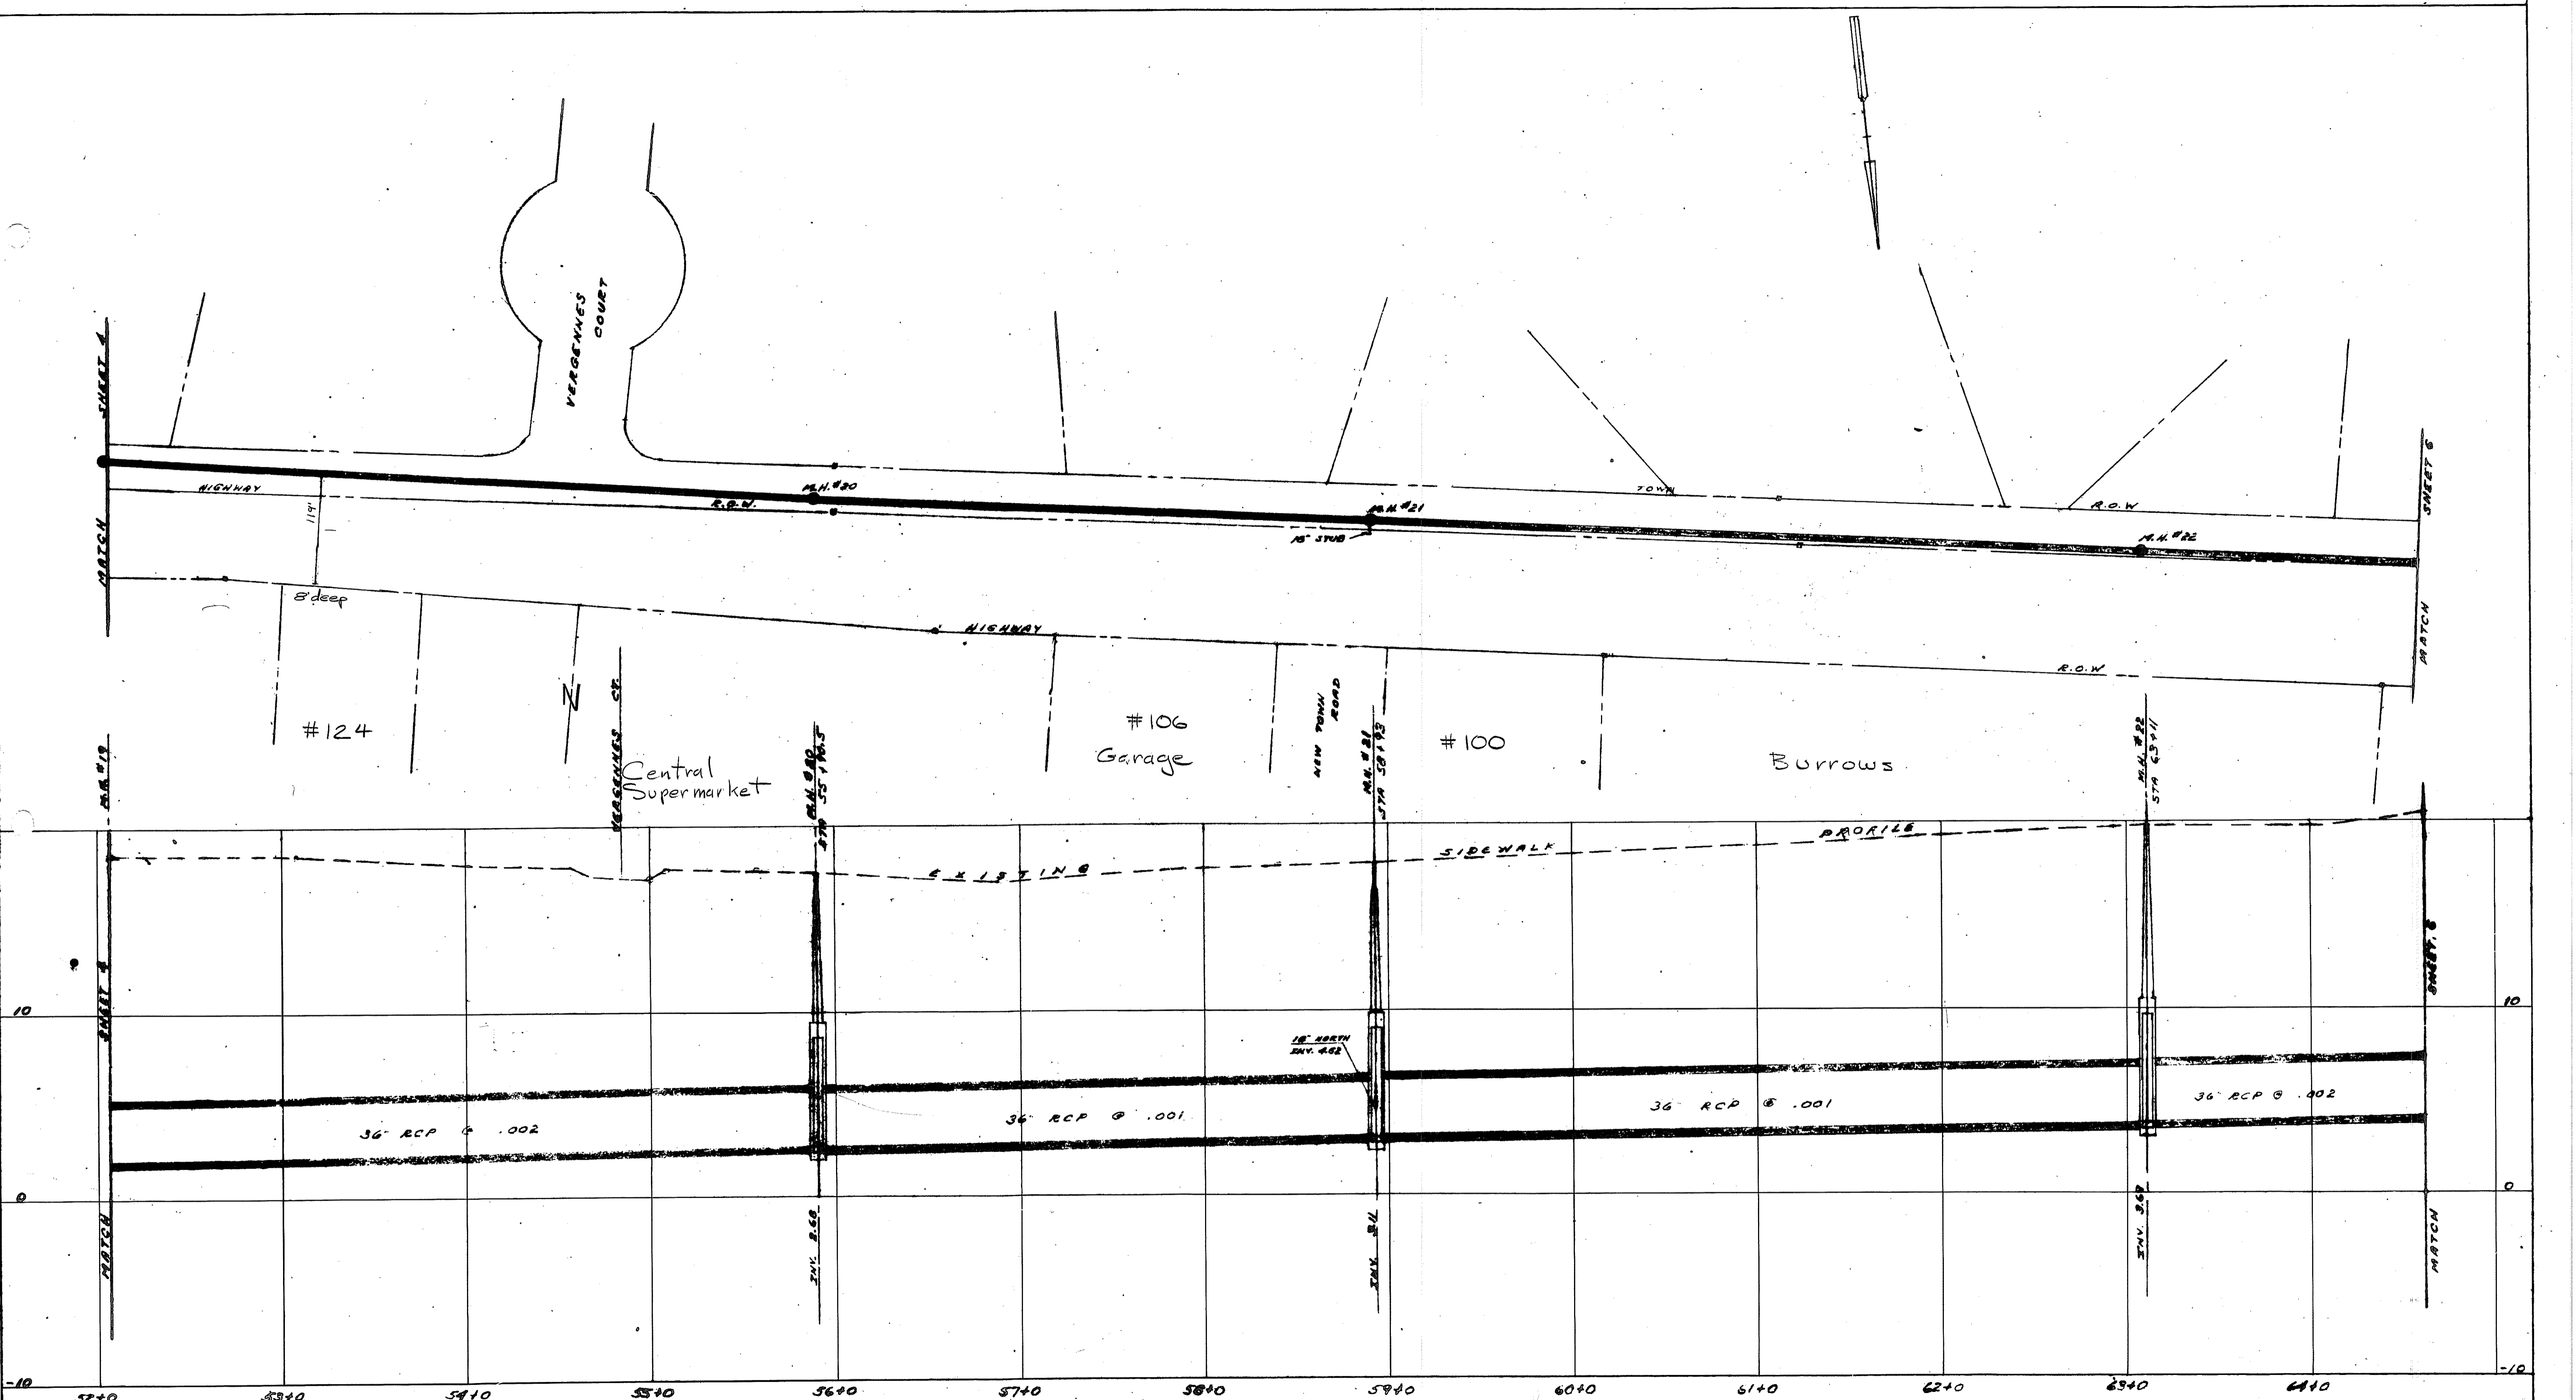


TOWN OF GROTON
 SANITARY SEWER RECORD PLAN P66
 LONG HILL TRUNK SEWER - FORT HILL ROAD
 HORIZ. 1"=40'
 VERT. 1"=4'
 JUNE 1970
 PREPARED BY
 THE DEPARTMENT OF PUBLIC WORKS
 SCALE

POCKET 18
 FOLDER 4

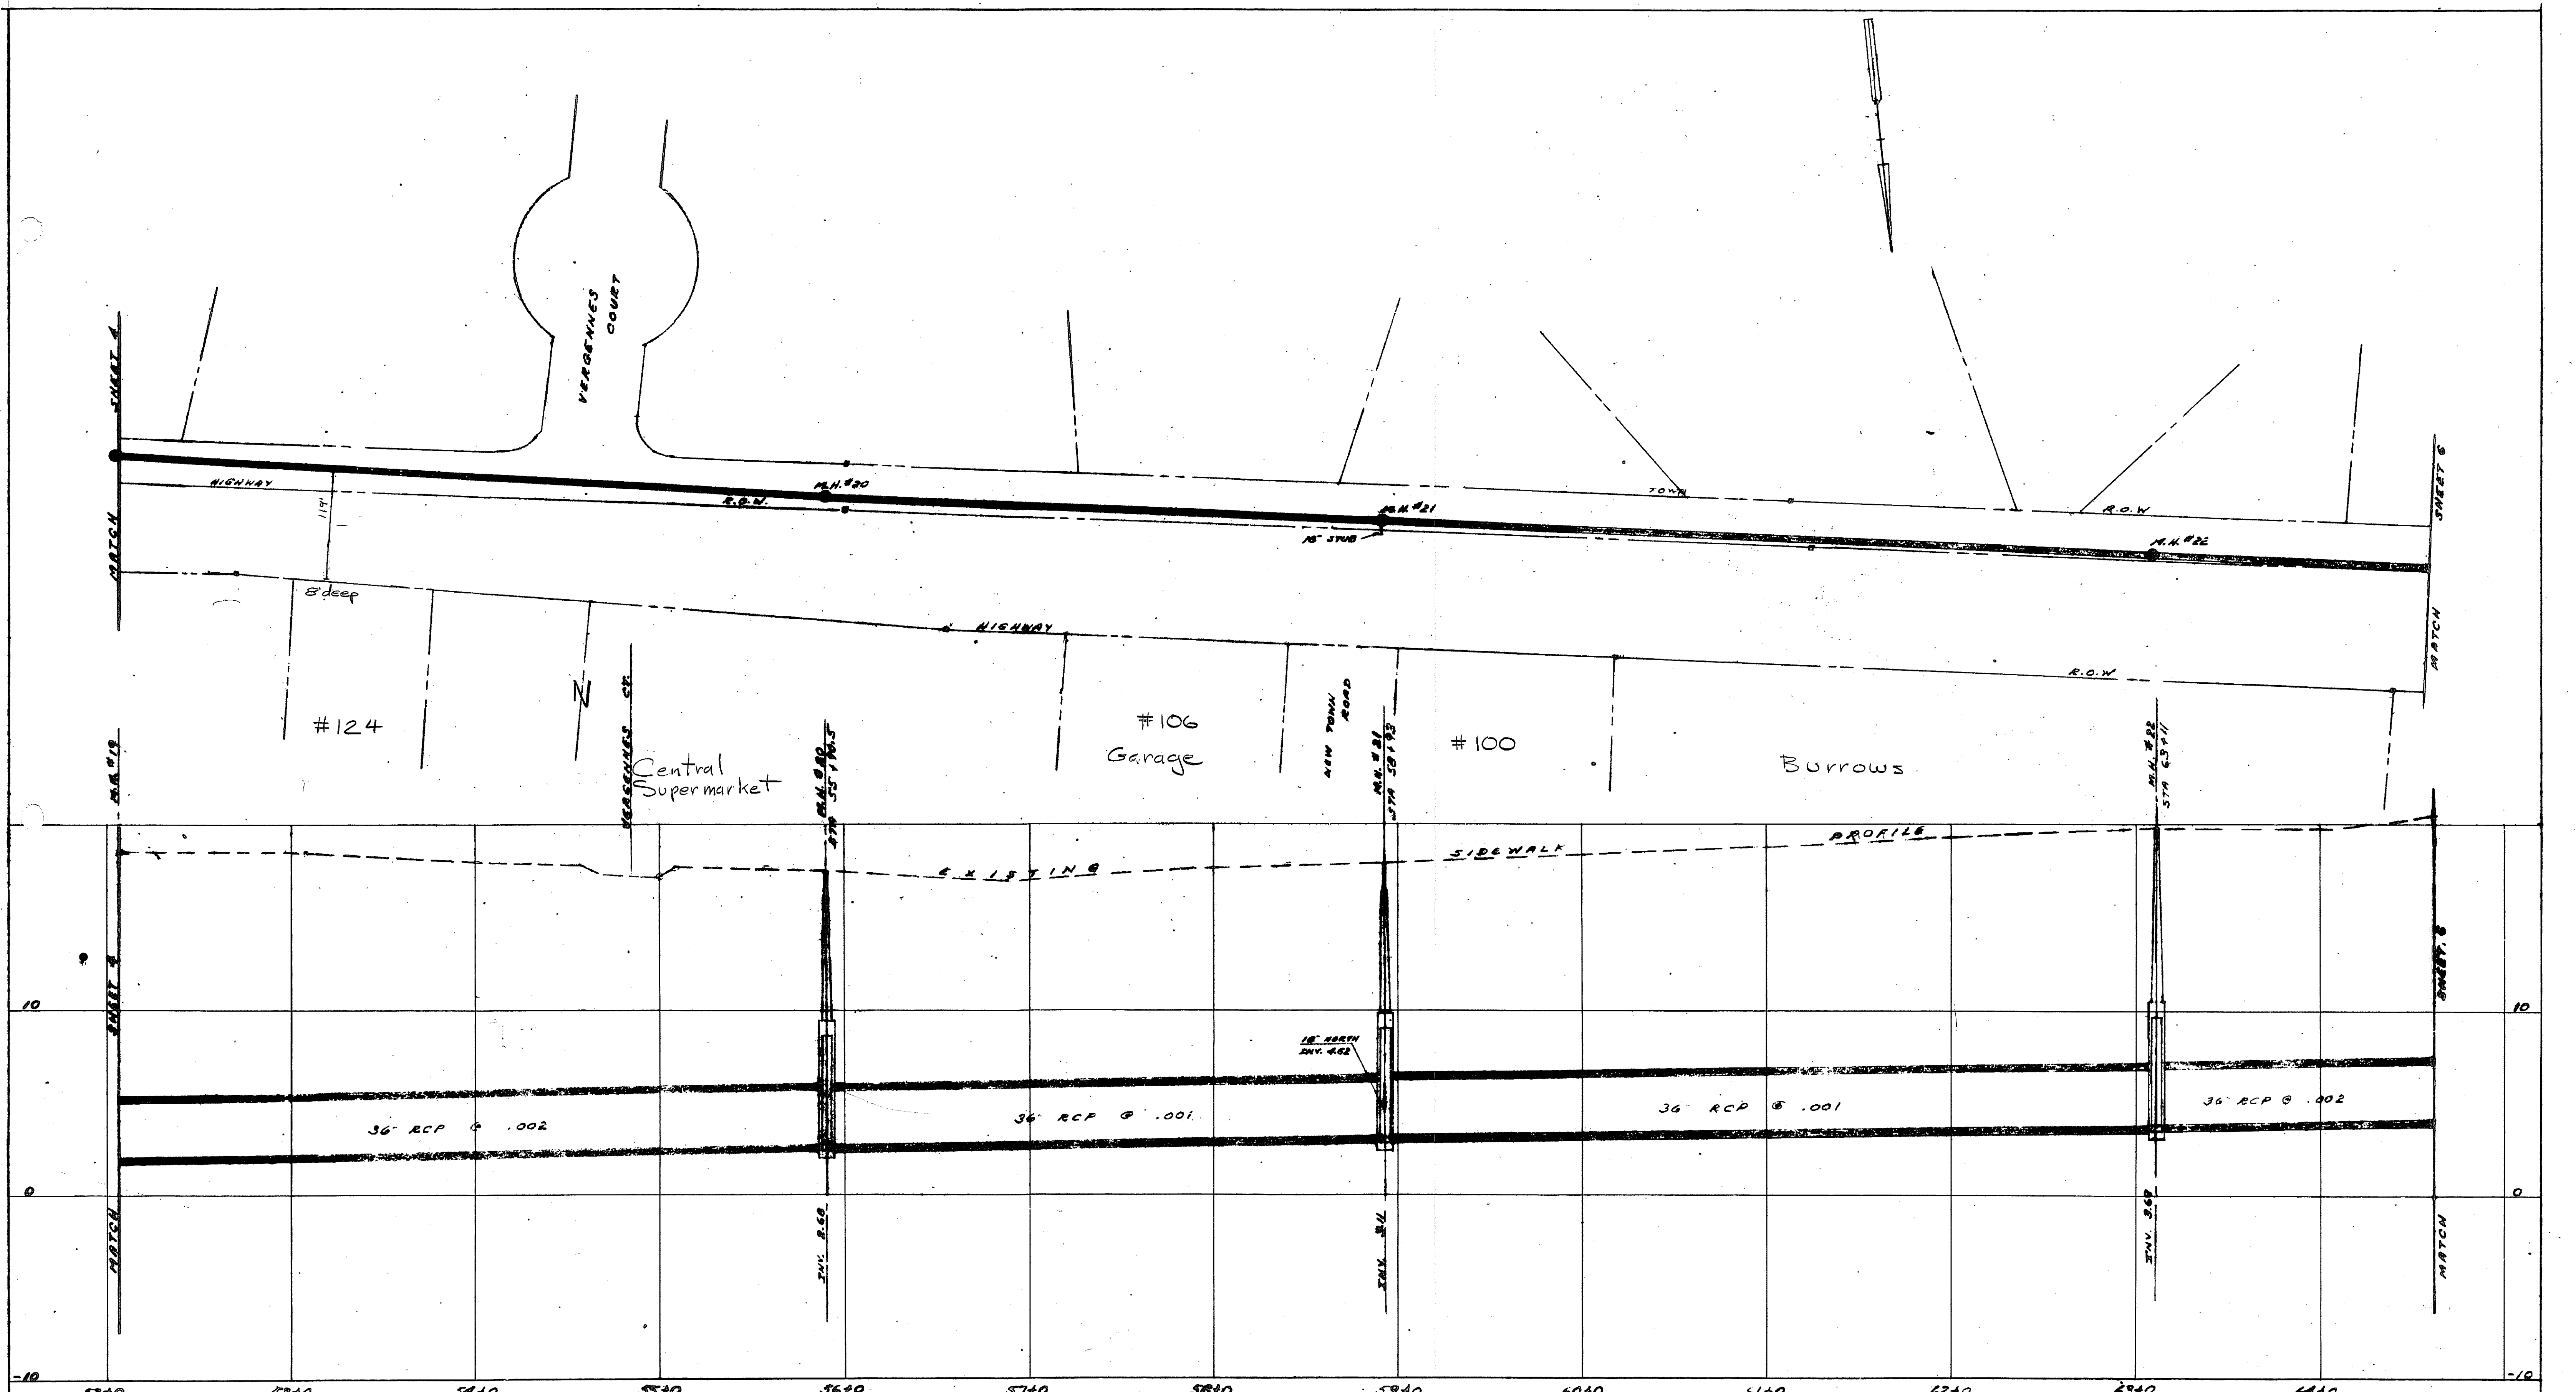


POCKET 18
FOLDER 4

TOWN OF GROTON
SANITARY SEWER RECORD PLAN P66
LONG HILL TRUNK SEWER - FORT HILL ROAD
HORIZ. 1"=40'
VERT. 1"=4'
JUNE 1970
PREPARED BY
THE DEPARTMENT OF PUBLIC WORKS
SCALE

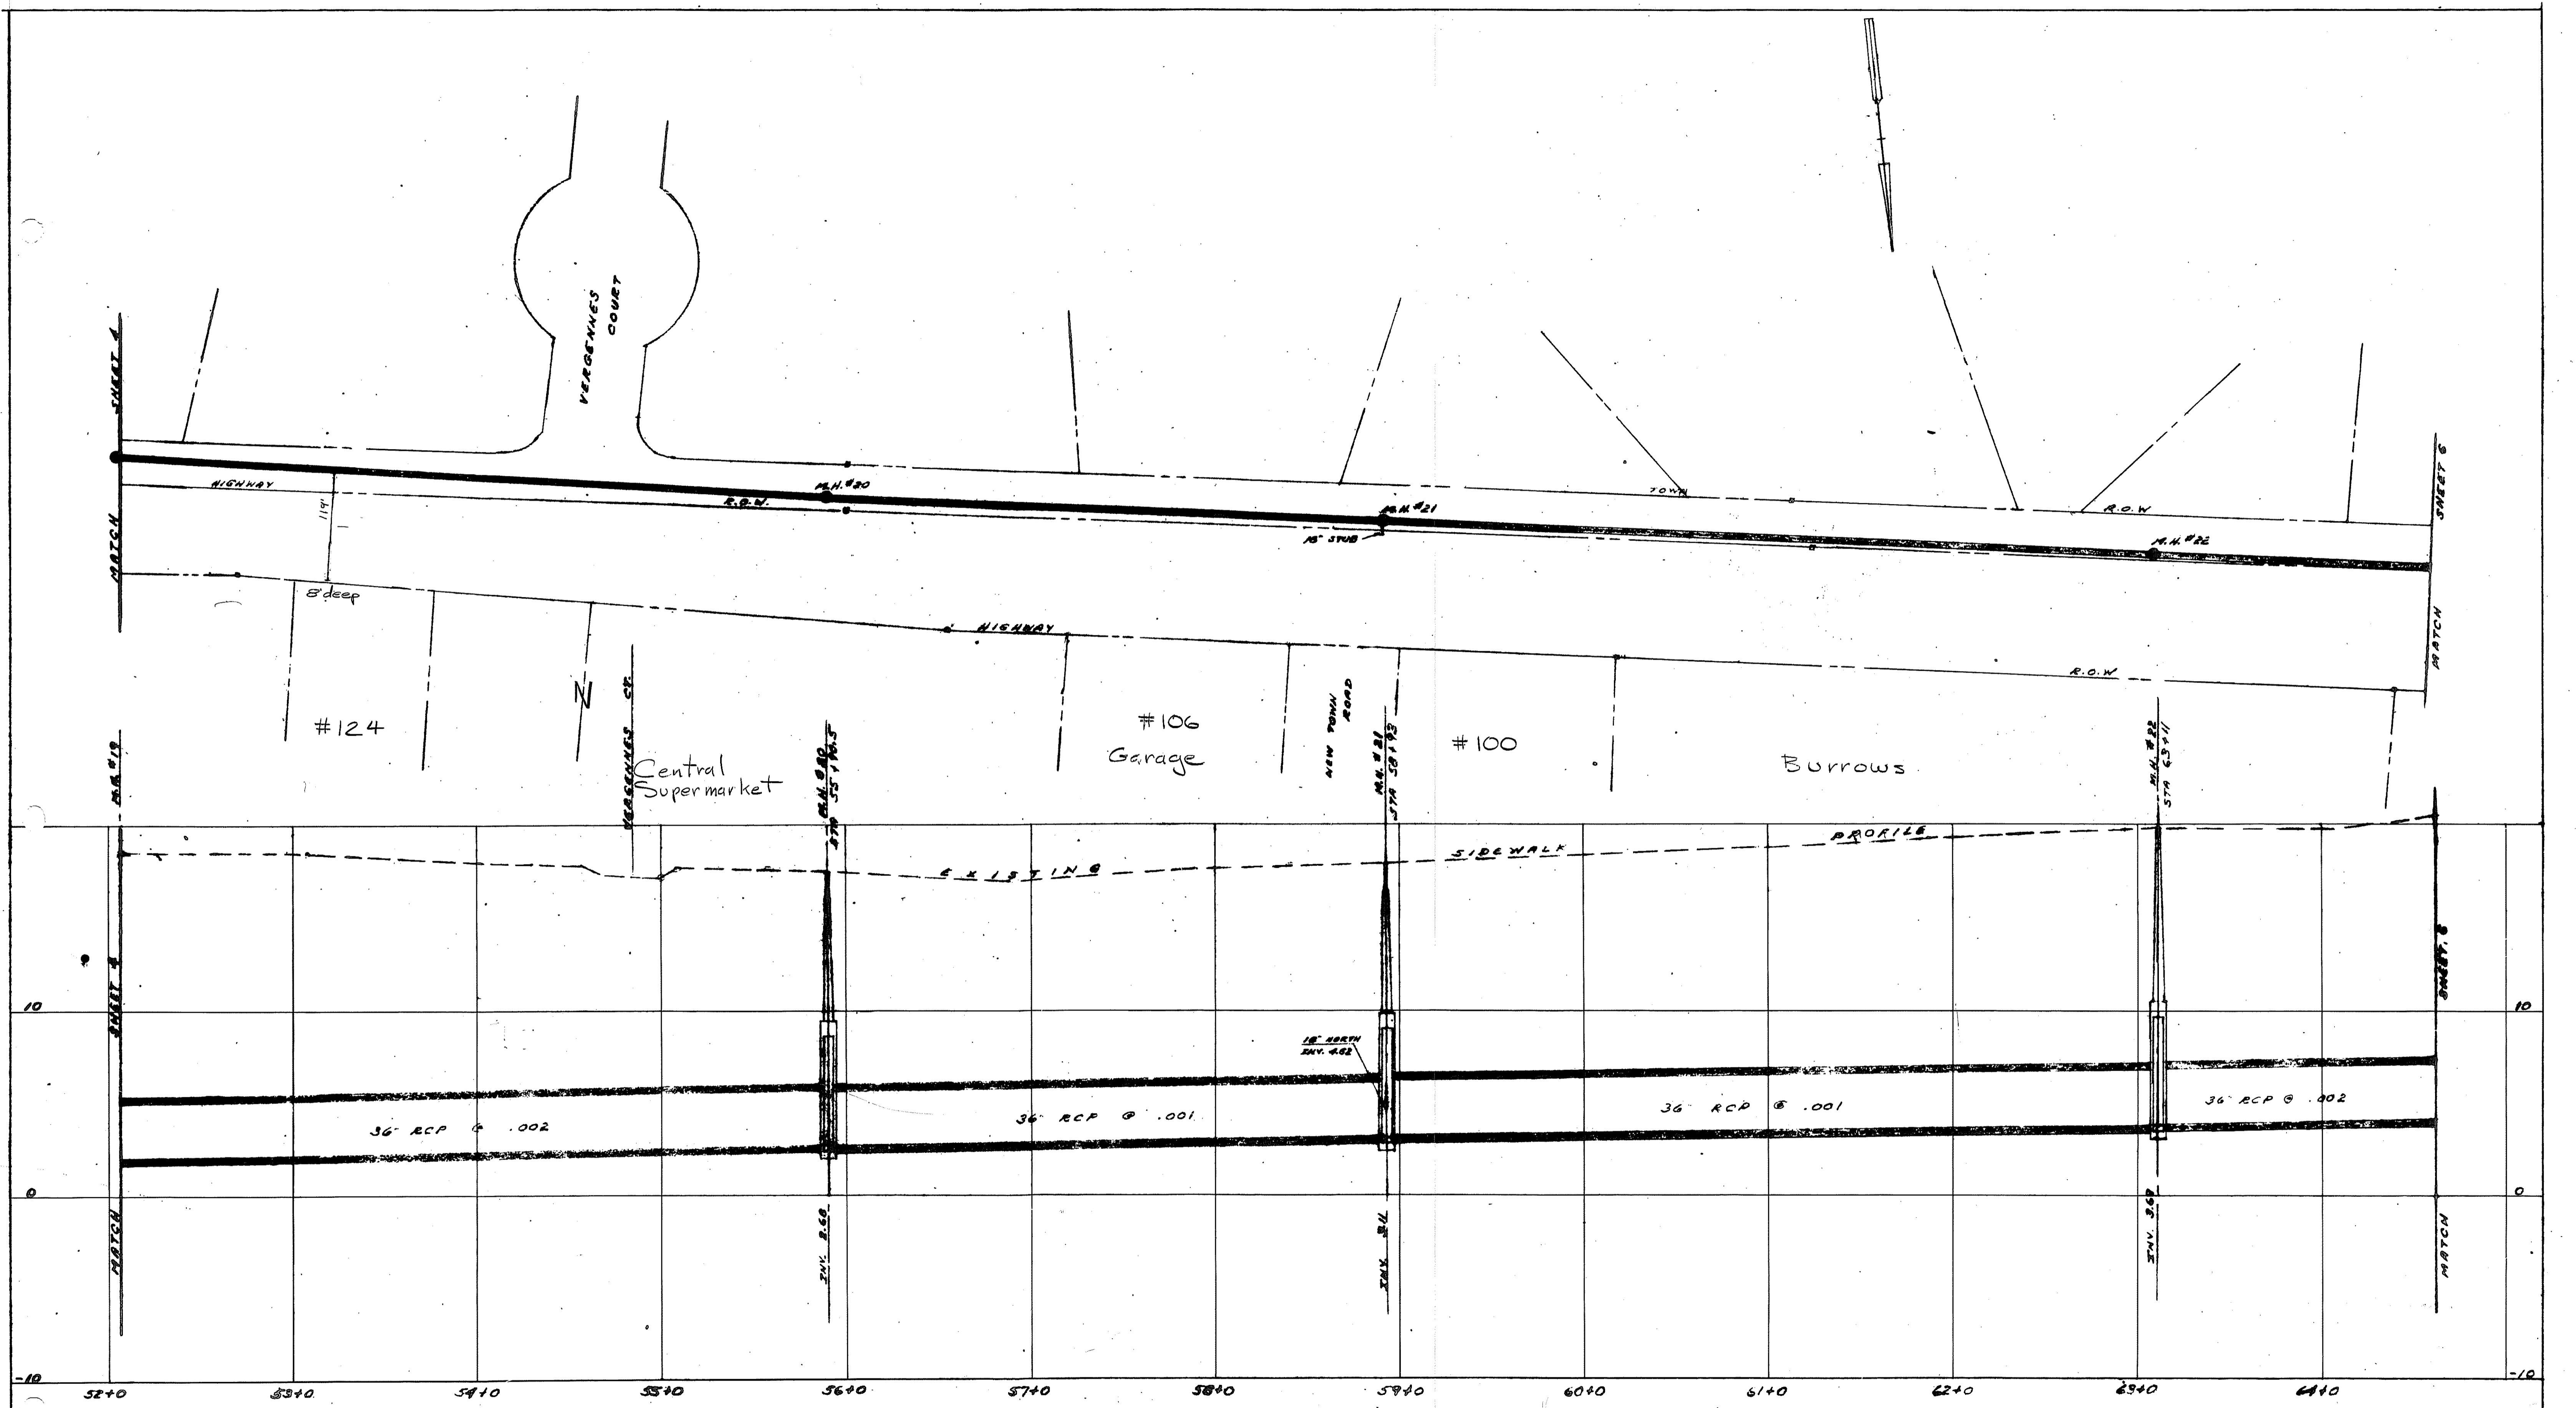


POCKET 18
 FOLDER 4

TOWN OF GROTON
 SANITARY SEWER RECORD PLAN P66
 LONG HILL TRUNK SEWER - FORT HILL ROAD
 HORIZ. 1"=40'
 VERT. 1"=4'
 JUNE 1970
 PREPARED BY
 THE DEPARTMENT OF PUBLIC WORKS
 SCALE

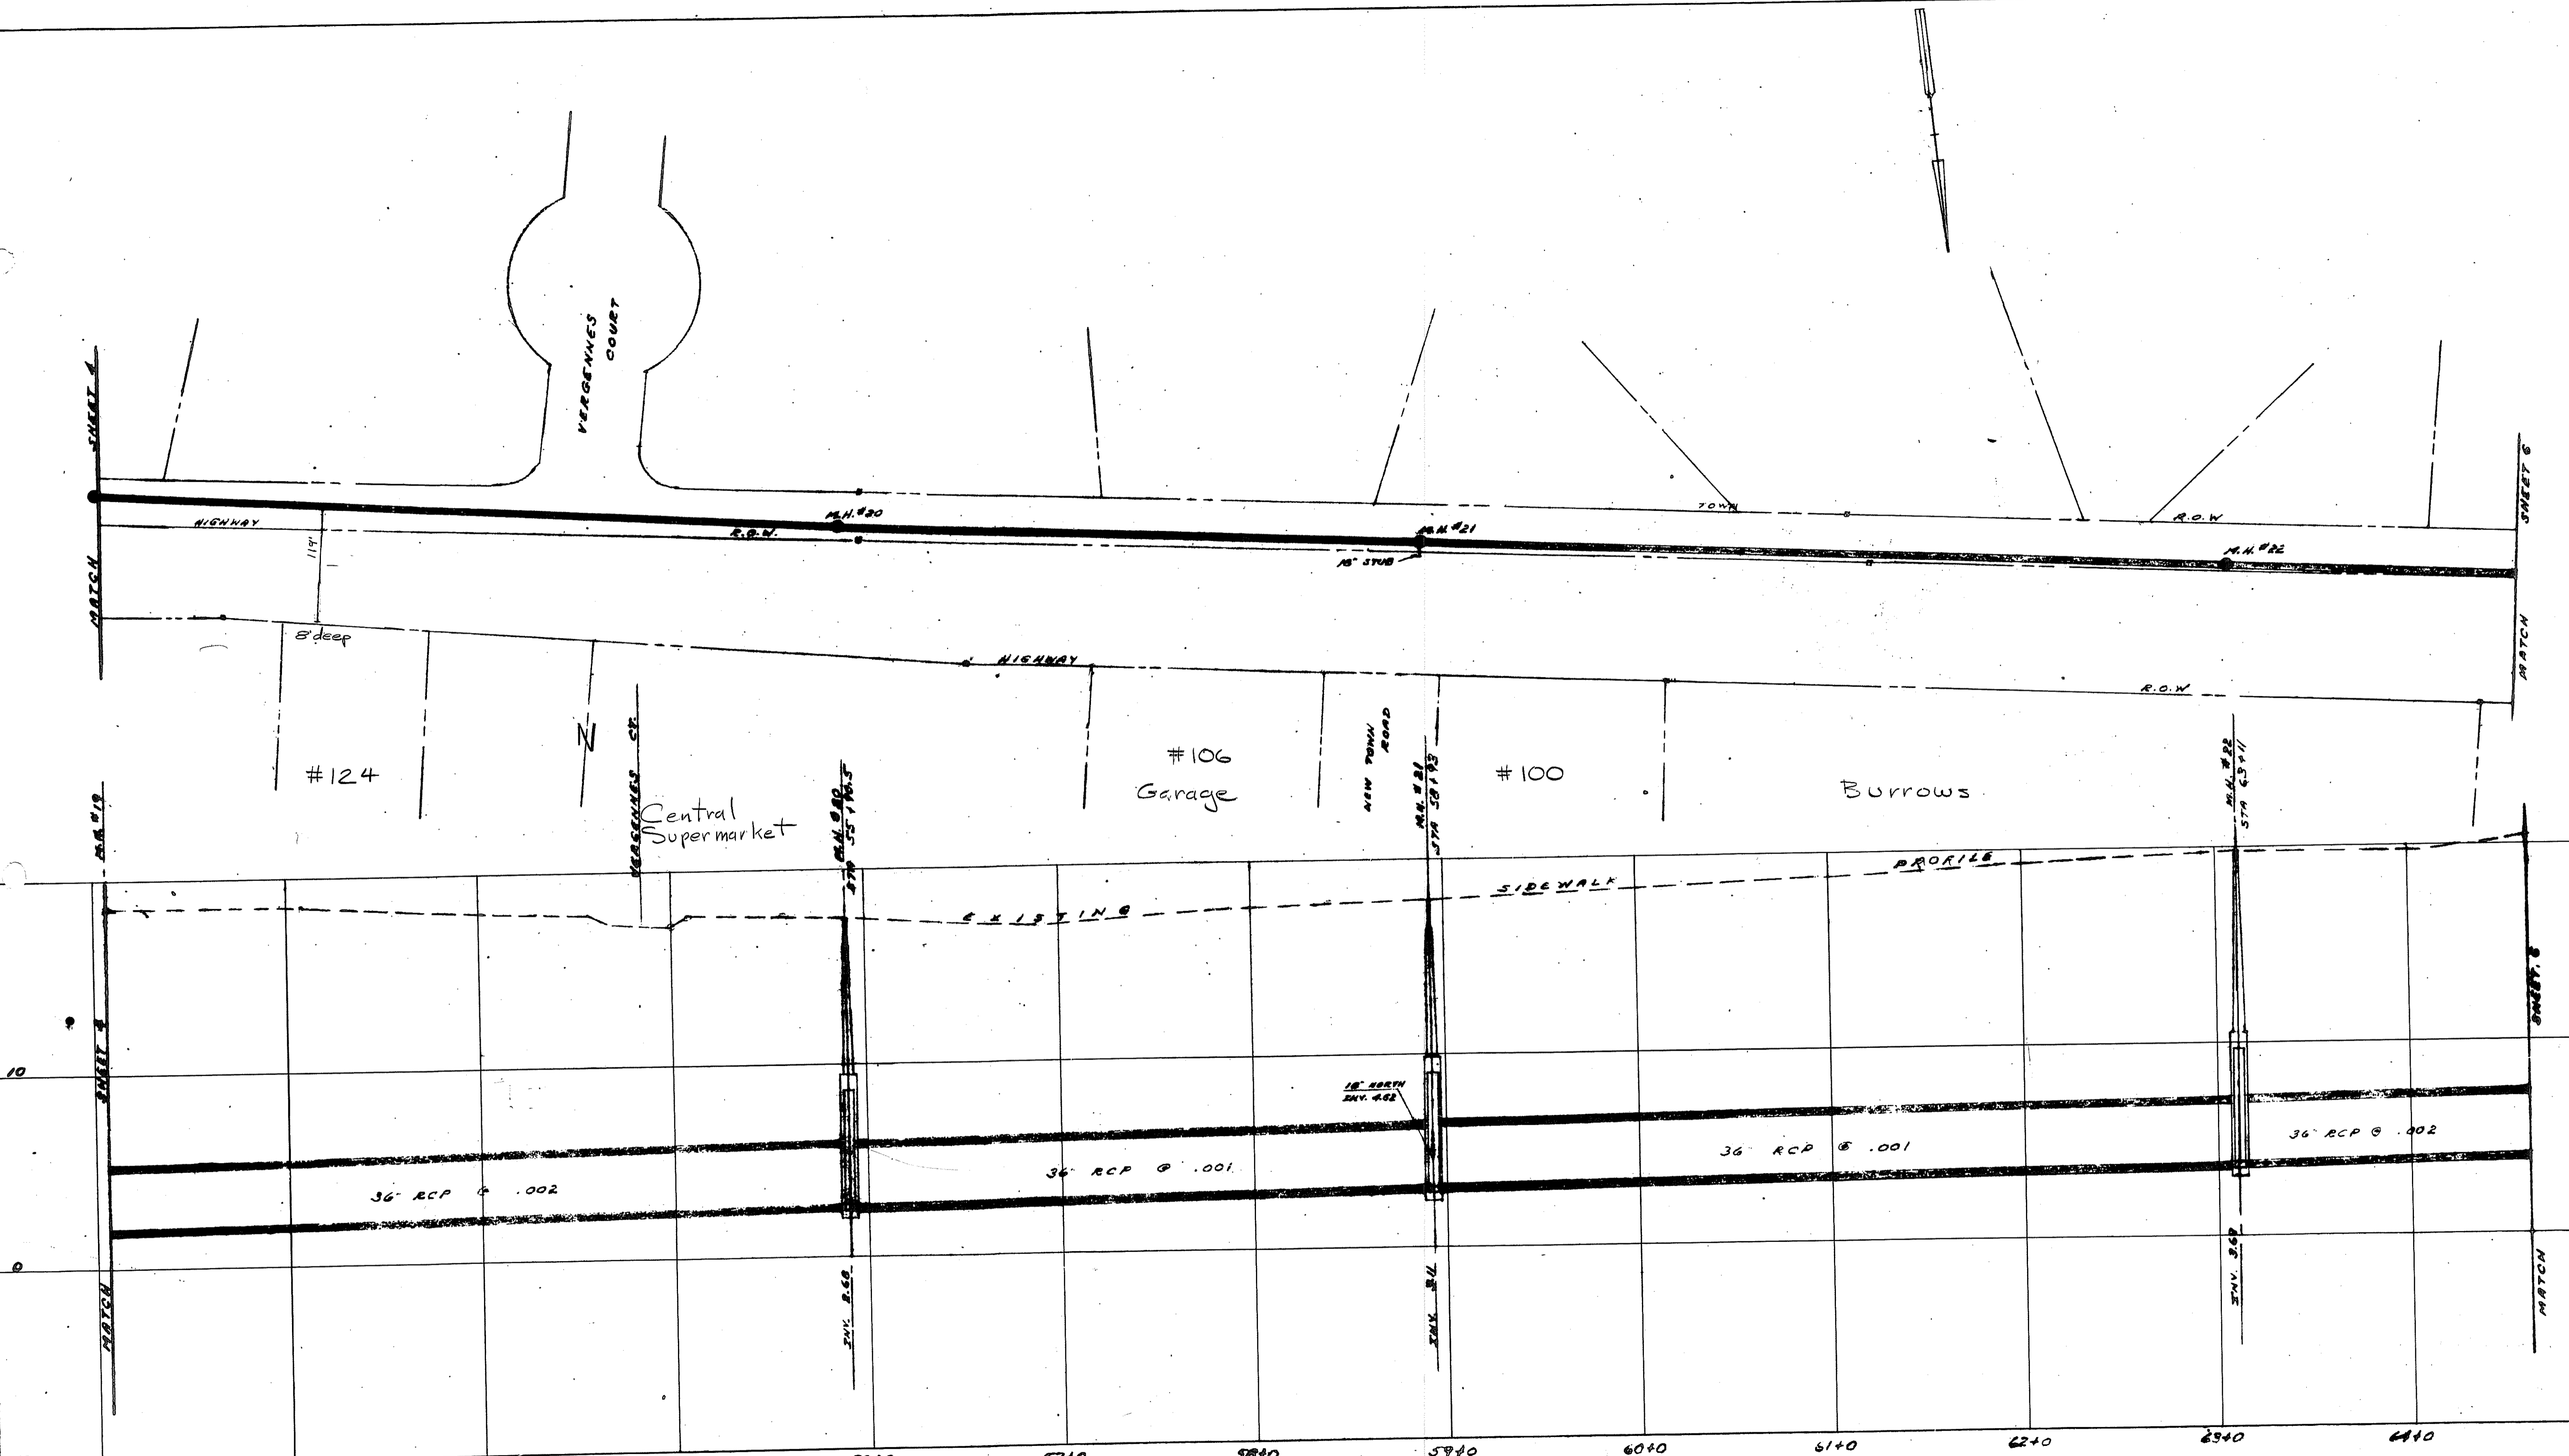


POCKET 18
 FOLDER 4
 PLAN 16 E

TOWN OF GROTON
 SANITARY SEWER RECORD PLAN
 LONG HILL TRUNK SEWER - FORT HILL ROAD
 SCALE HORIZ. 1"=40'
 VERT. 1"=4'
 PREPARED BY
 THE DEPARTMENT OF PUBLIC WORKS

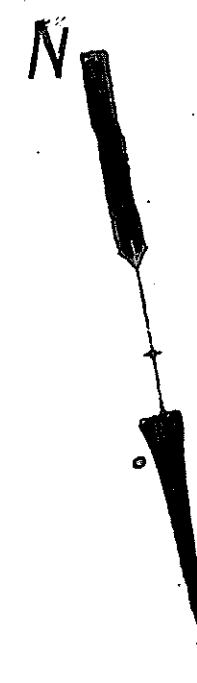

Fitch
J.H.S.



Town Hall
45

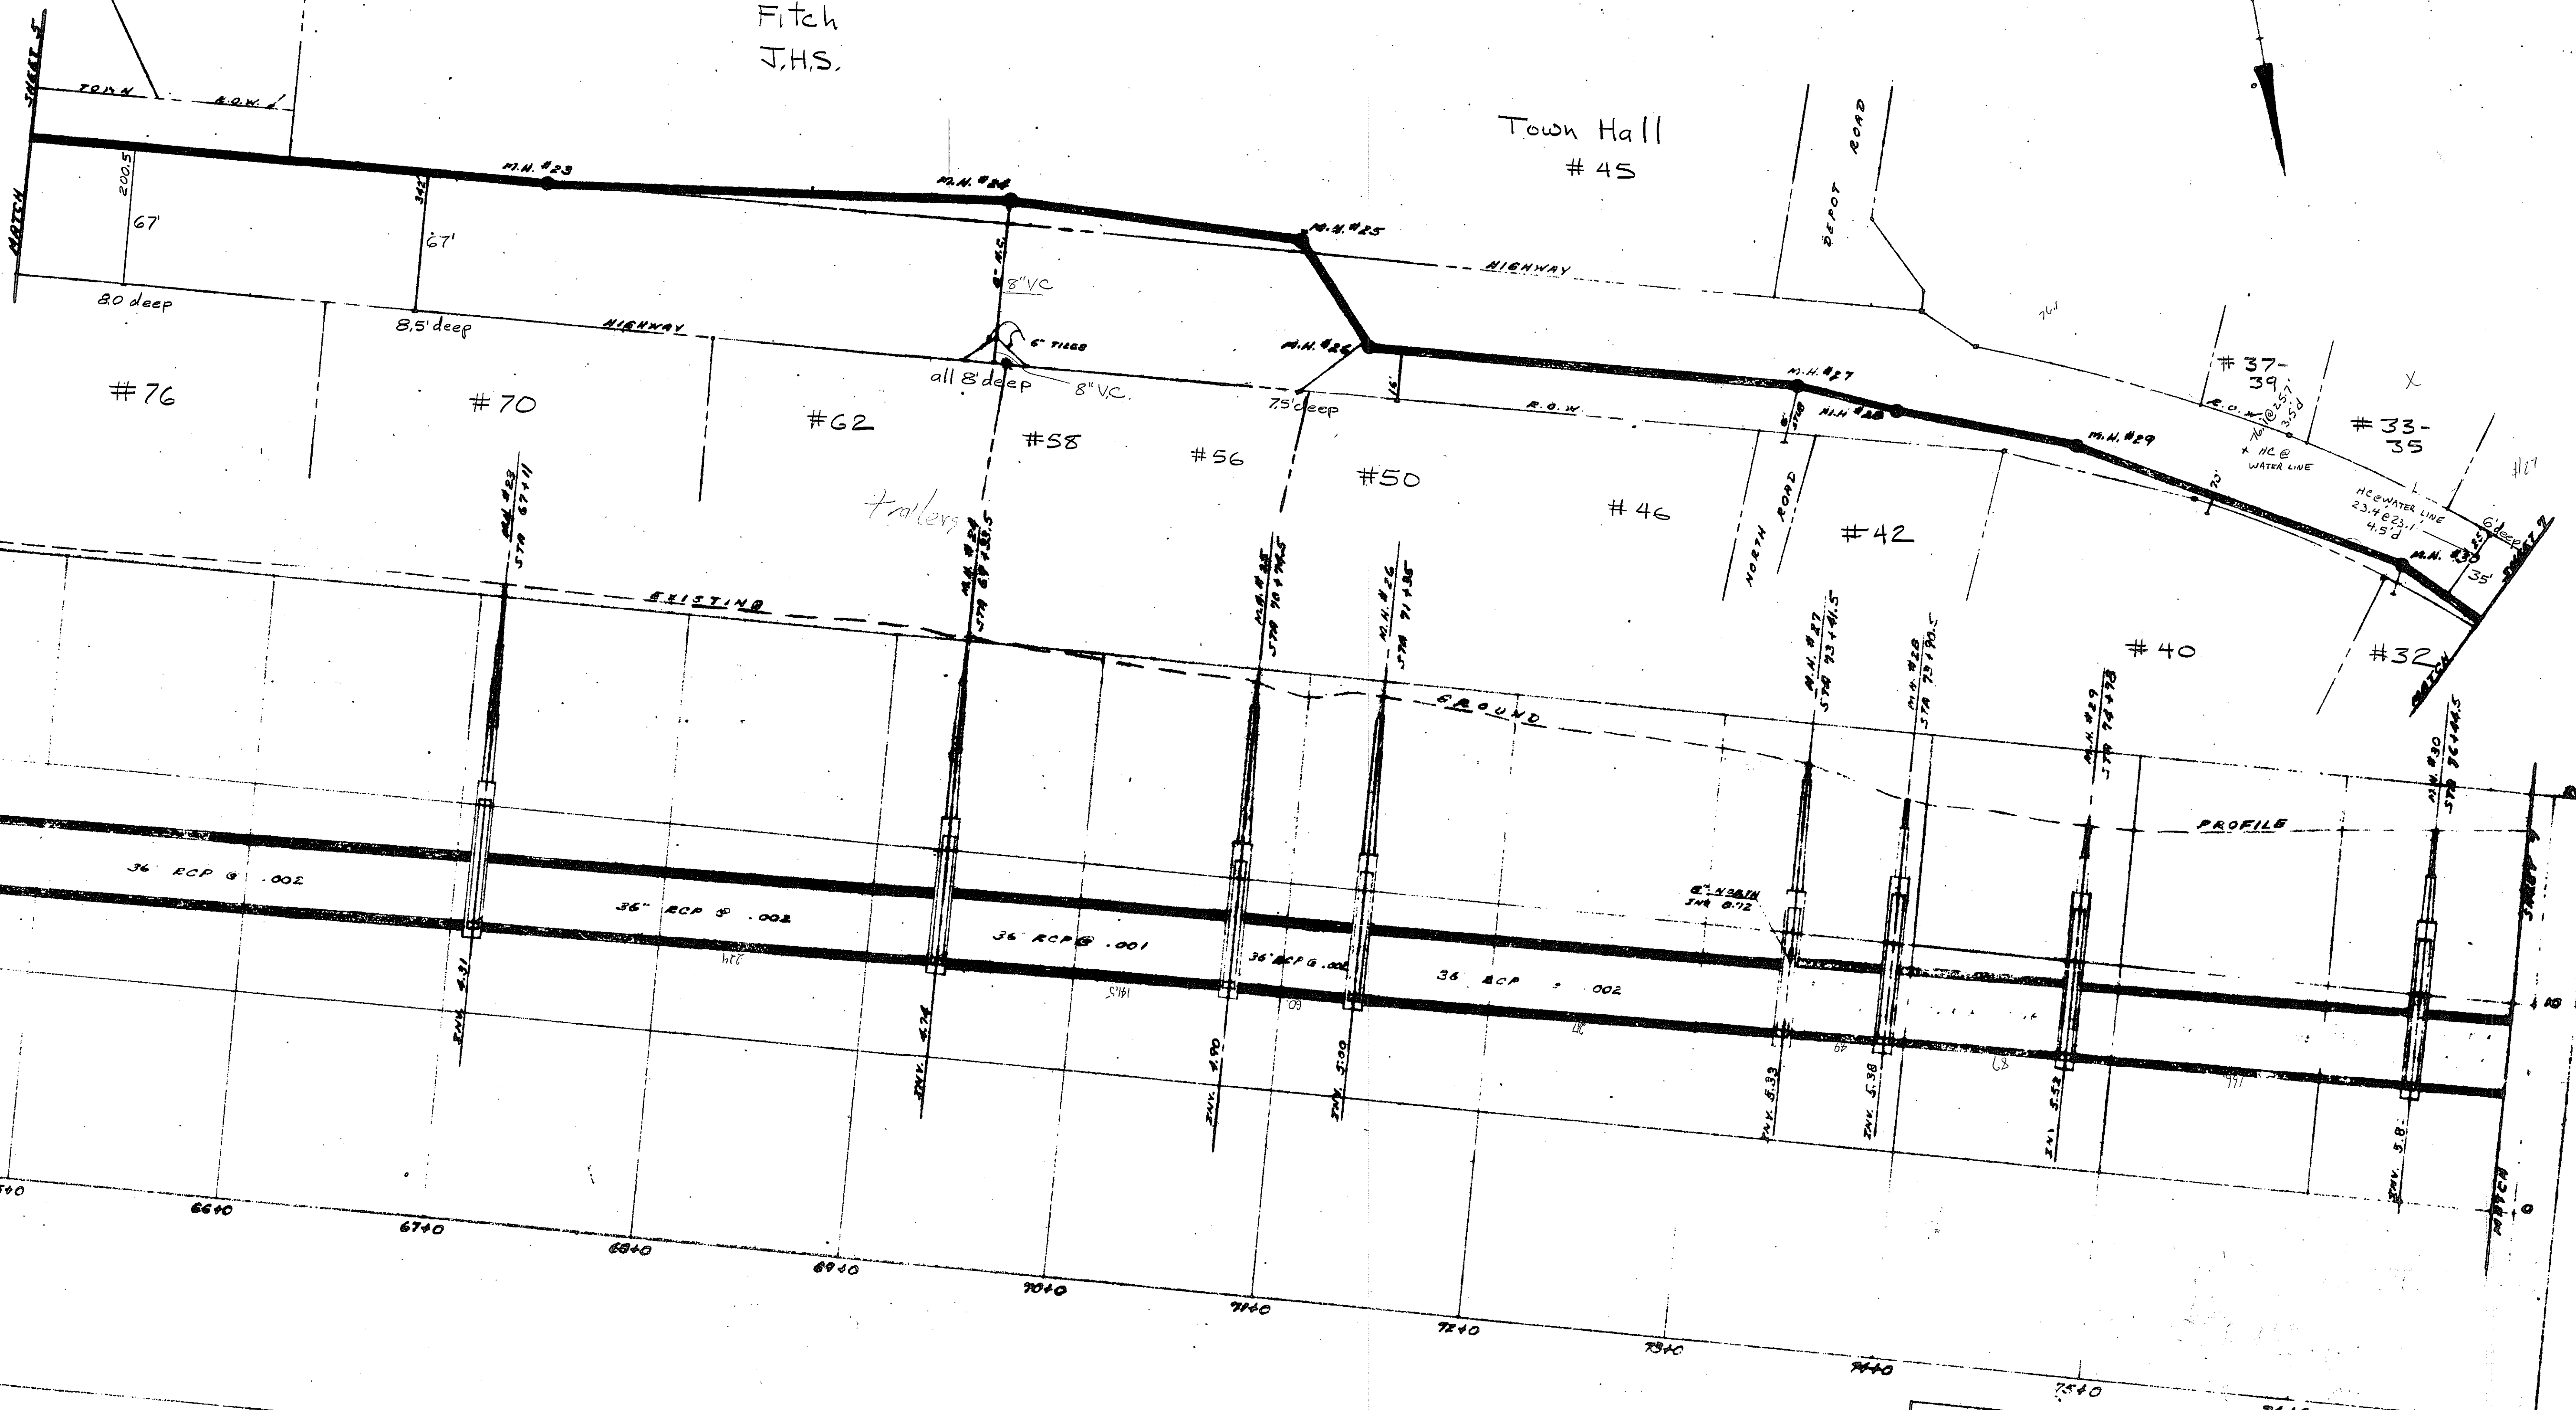

POCKET 12
 FOLDER 4
 PLAN 16 F

TOWN OF GROTON
 SANITARY SEWER RECORD PLAN
 FORT HILL TOWN SEWER - FORT HILL RONE
 SCALE: VERT 1/2"


P 67

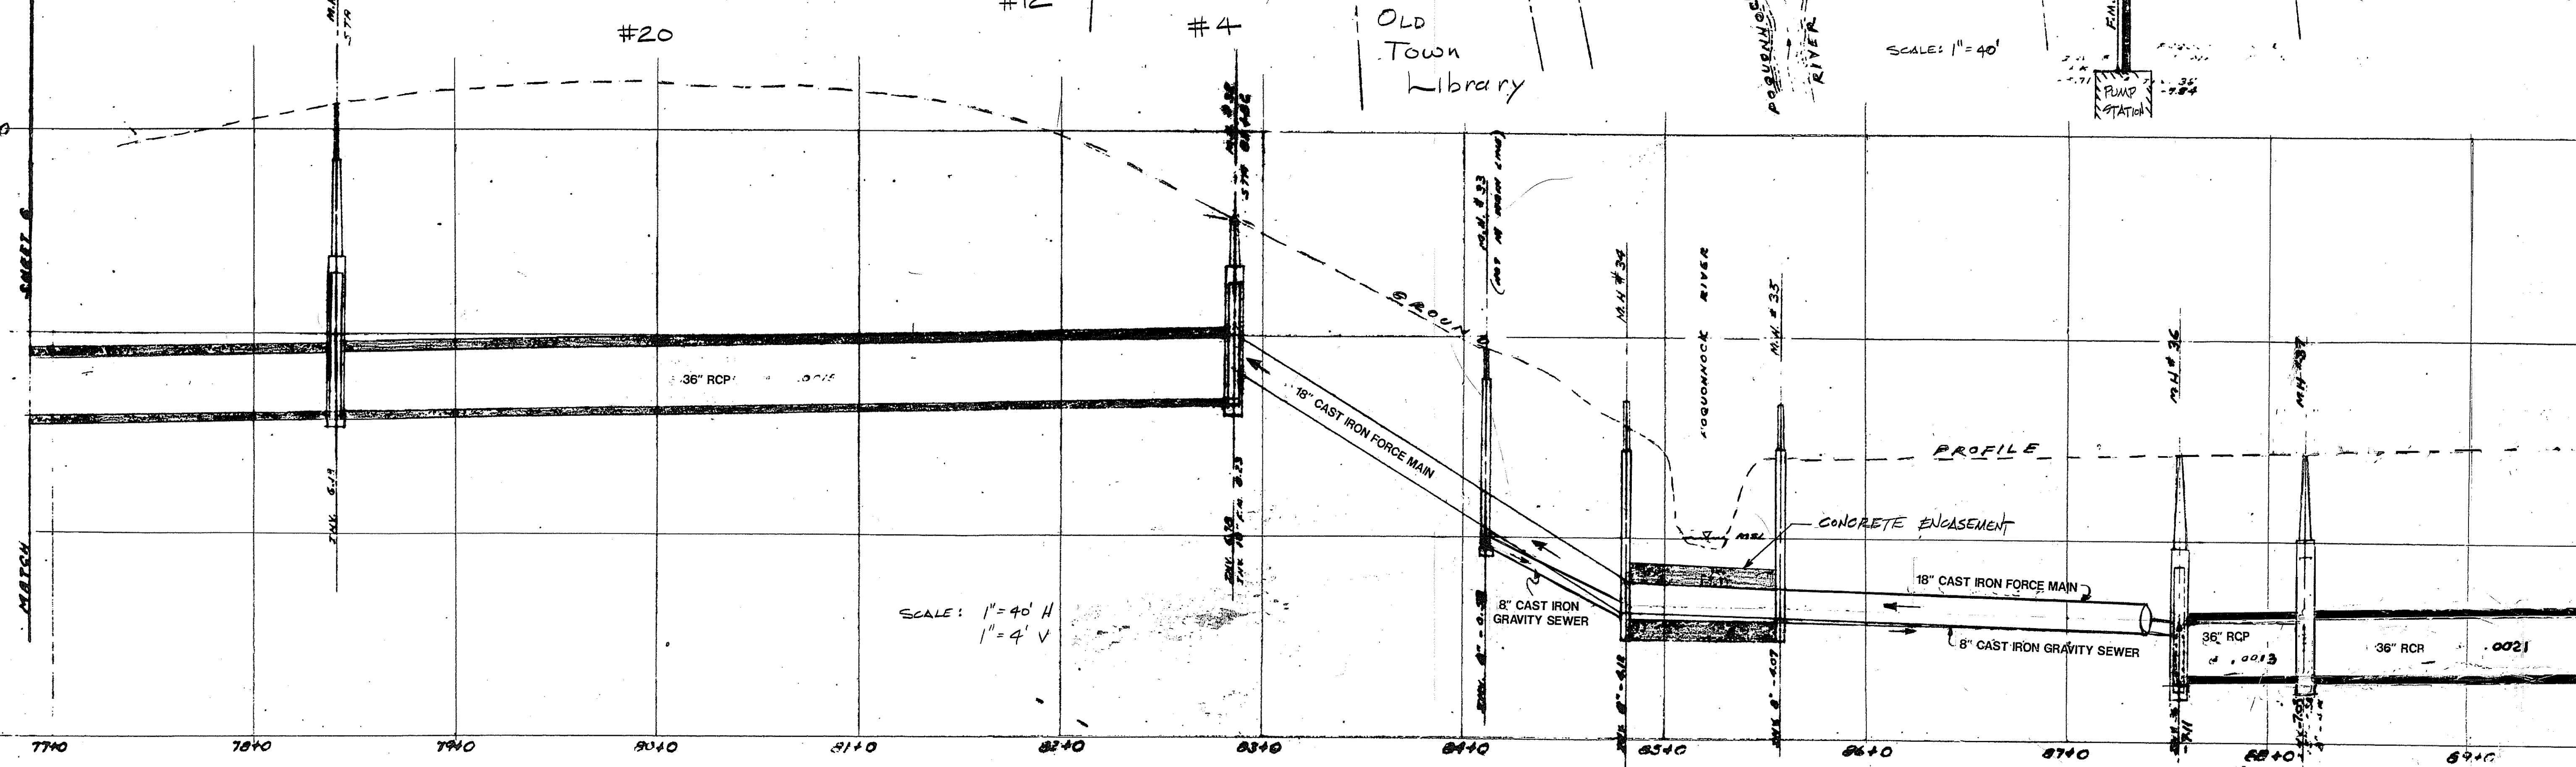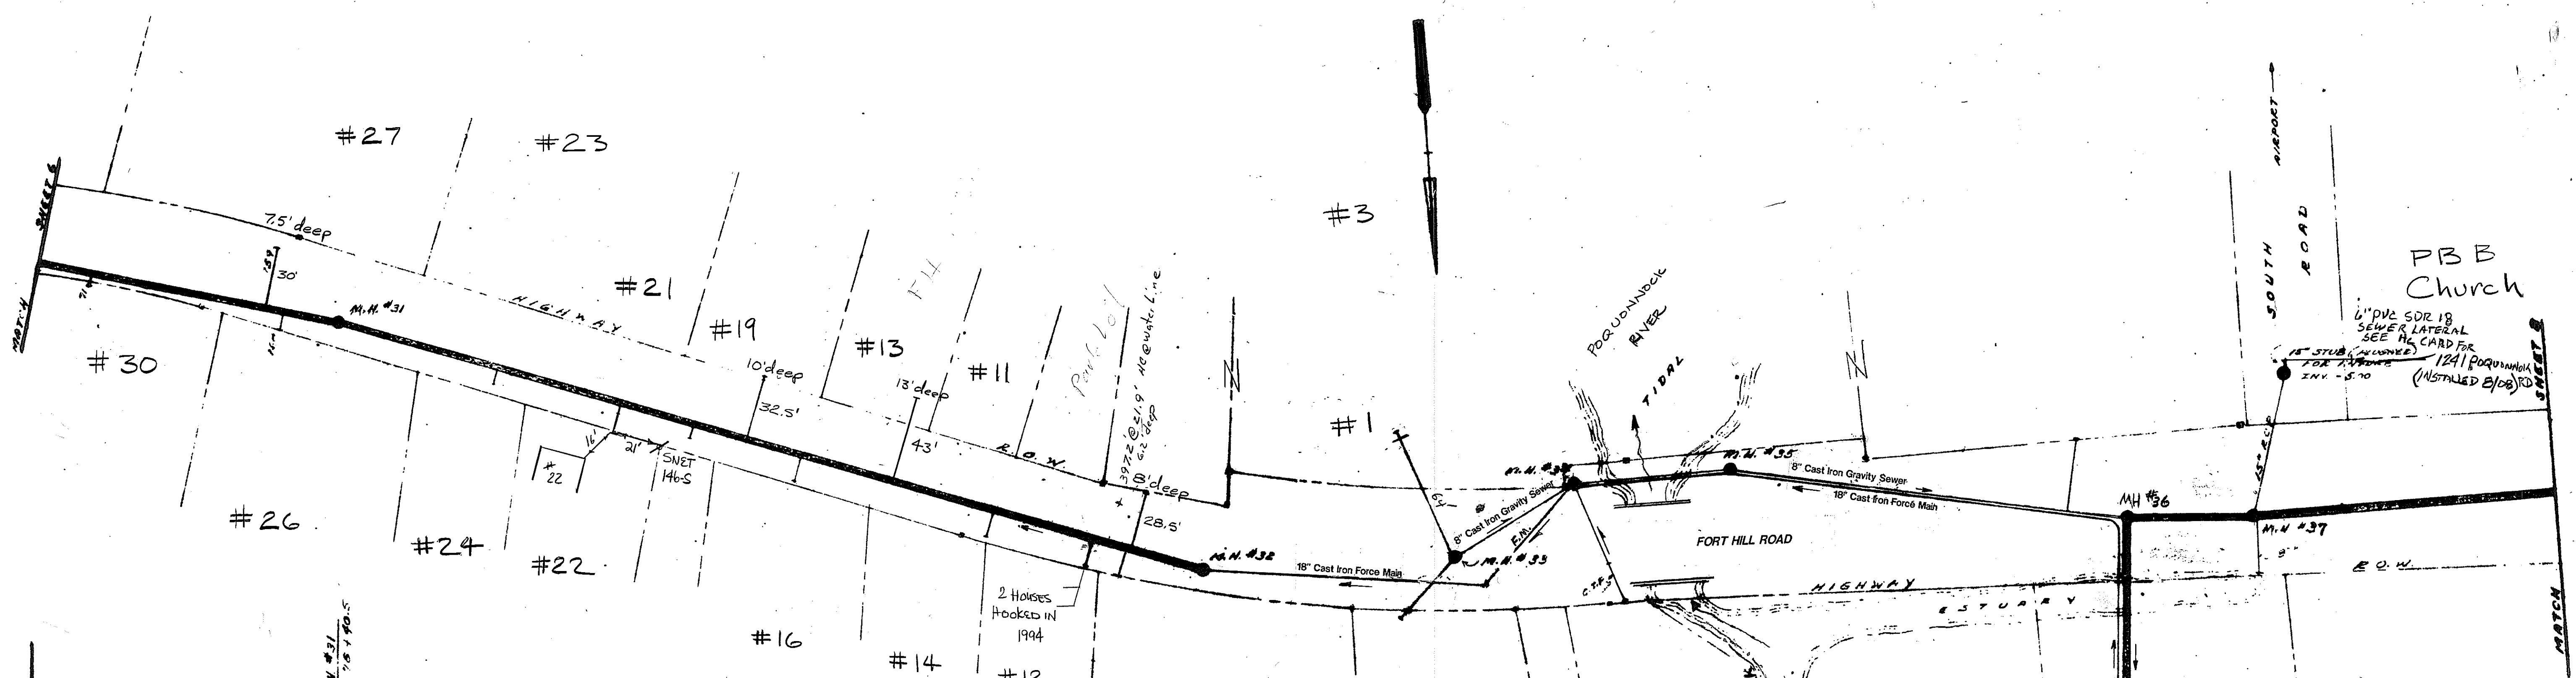


REVISION:
 6/13/91 - CHANGED INV. & SLOPE
 TARR, MA # 37.

POCKET 18
 FOLDER 4
 PLAN 16 G

TOWN OF GROTON
 SANITARY SEWER RECORD PLAN
 LONG HILL TRUNK SEWER FORT HILL ROAD
 HORIZ. 1" = 40'
 SCALE VERT. 1" = 4'
 PREPARED BY
 THE DEPARTMENT OF PUBLIC WORKS
 JUNE 1970

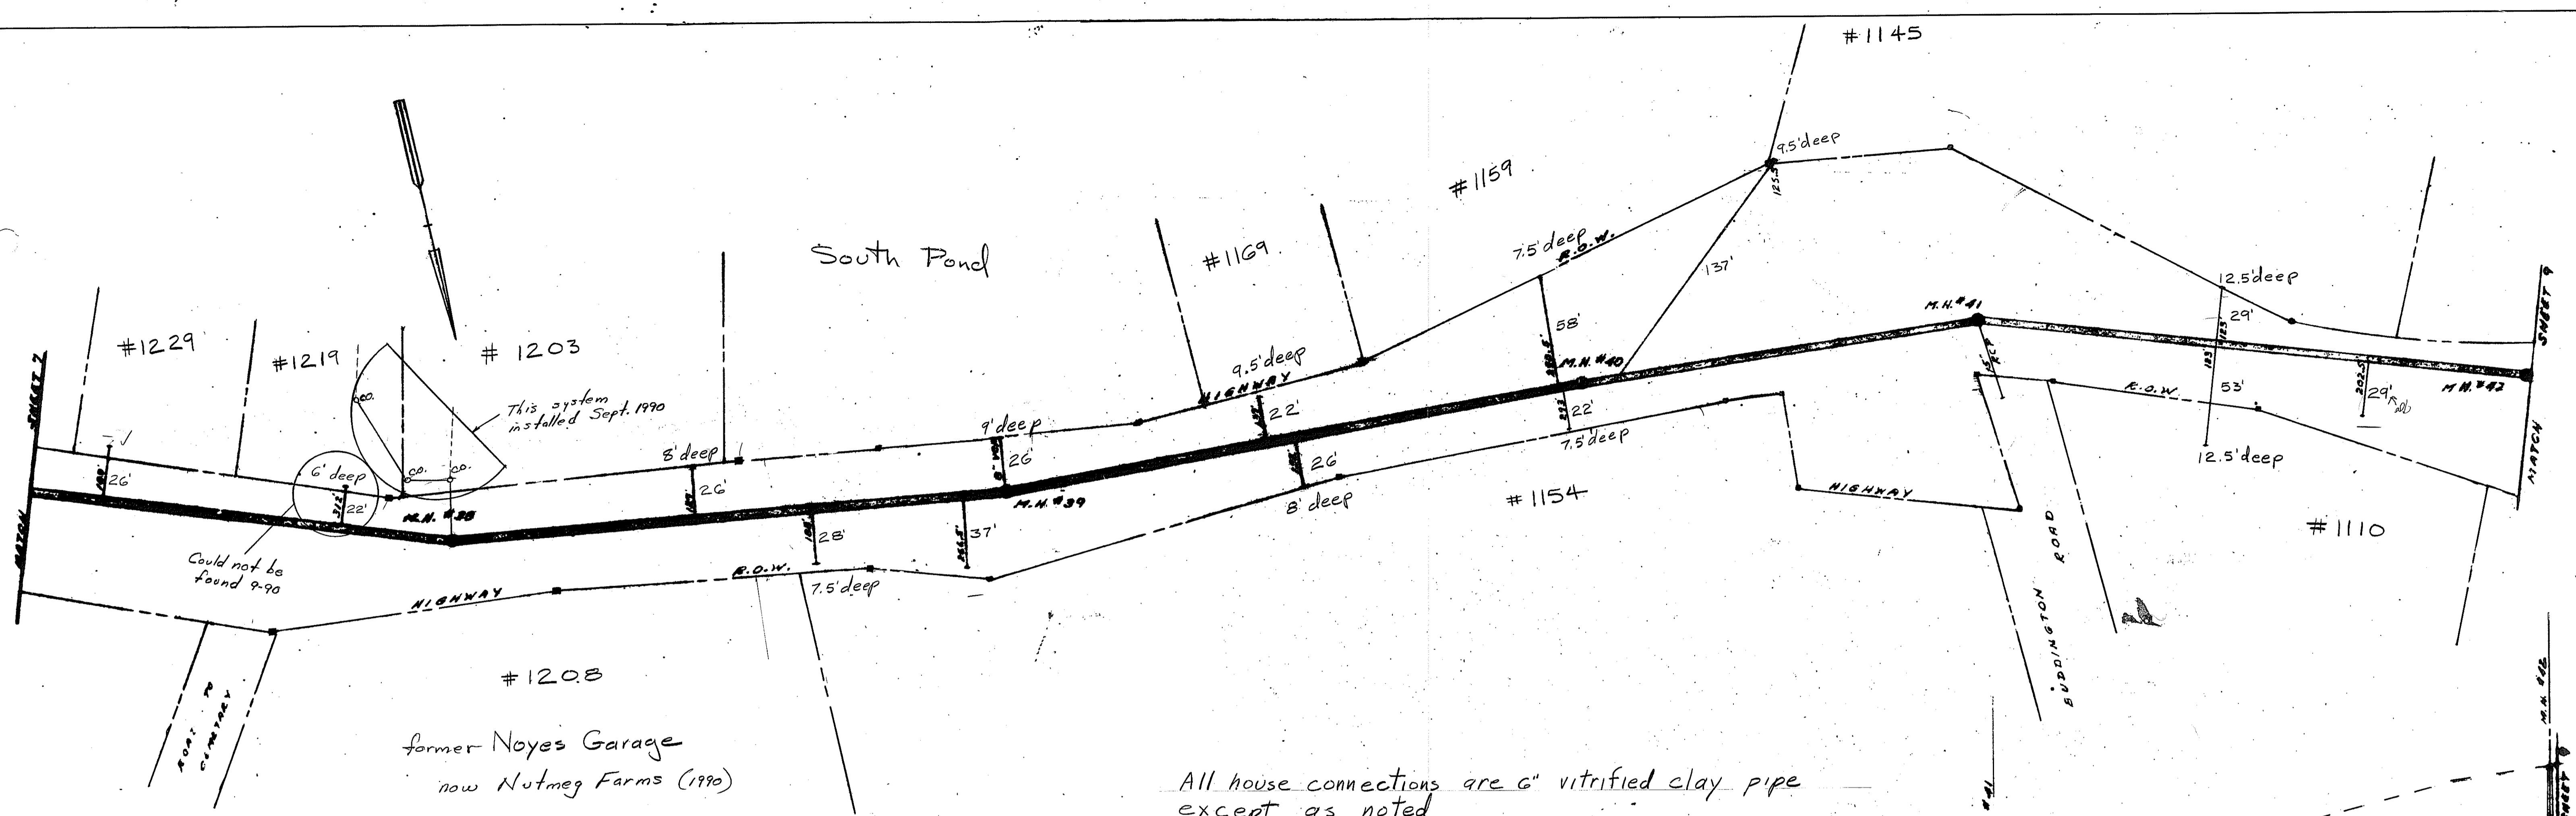

All house connections are 6" vitrified clay pipe except as noted

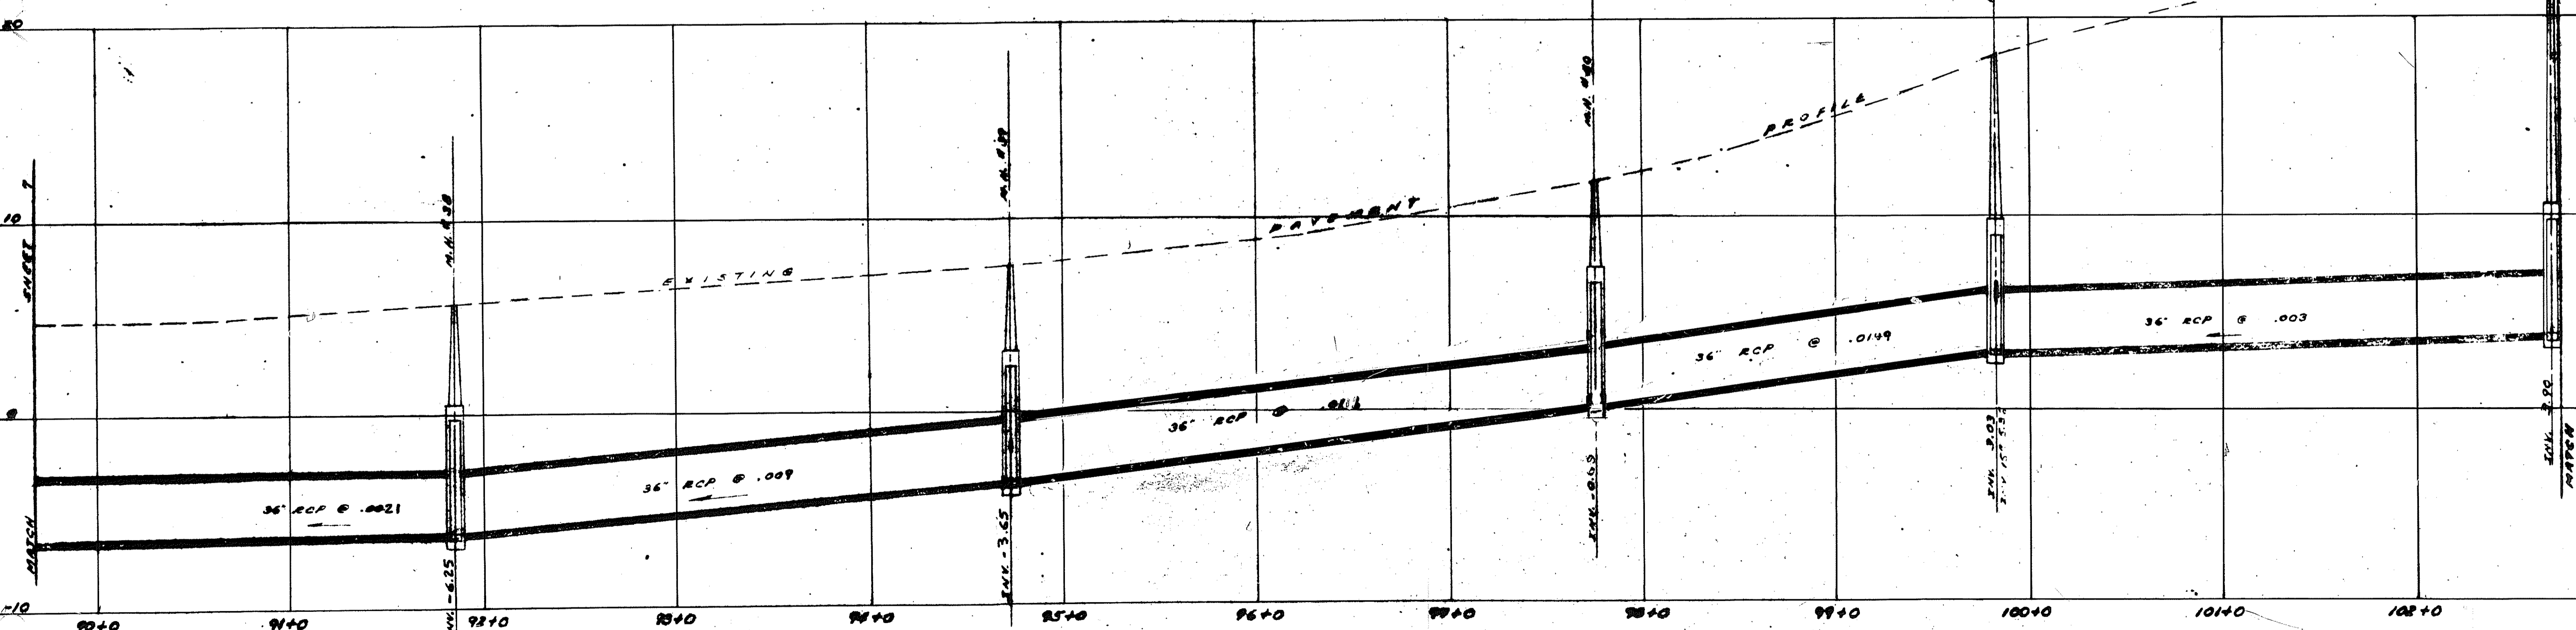

REVISION:
 6-13-91 - CHANGED INVS AT
 MH#38 & #39 & SLOPE OUT OF MH#38.
 6-20-91 - CHANGED INV. AT MH#40
 CHANGED SLOPE IN & OUT OF MH#40.

POCKET 18
 FOLDER 4
 PLAN 16.H

TOWN OF GROTON
 SANITARY SEWER RECORD PLAN
 LONG HILL TRUNK SEWER - POQUONNOCK ROAD
 HORIZ. 1" = 40'
 SCALE: VERT. 1" = 4'
 JUNE 1970
 PREPARED BY
 THE DEPARTMENT OF PUBLIC WORKS
 AS BUILT LONG HILL TRUNK SHEET 8 OF 1